


AS INSTALLED FRONT ELEVATION
Scale 1:50

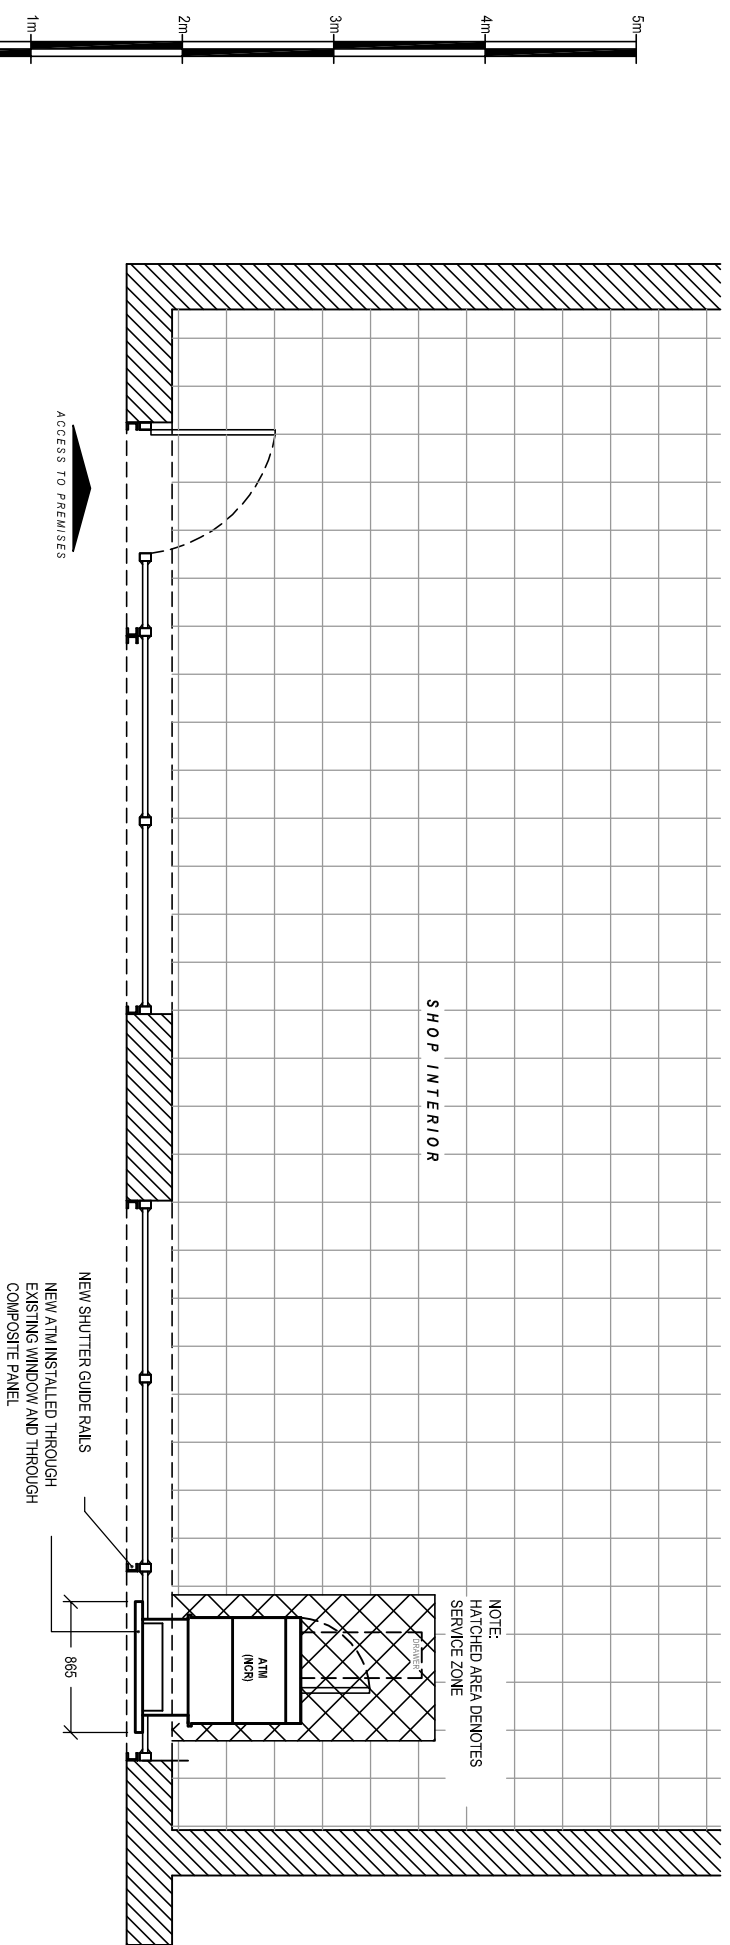

AS INSTALLED PART PLAN
Scale 1:50

Date:	Comments:	By:

GENERAL NOTES:
1) All dimensions in millimeters unless otherwise stated.

Site:
ATKAR CONVENIENCE
9 Chichester Road,
South Shields,
NE33 4AA

Drawing Title:
As Installed Elevation and Plan

Ref:	Date:	Rev:
NM-2015-07-41-2	14.07.15	
Scale:	Paper:	Date Rev:
1:50	A3	