


West Elevation

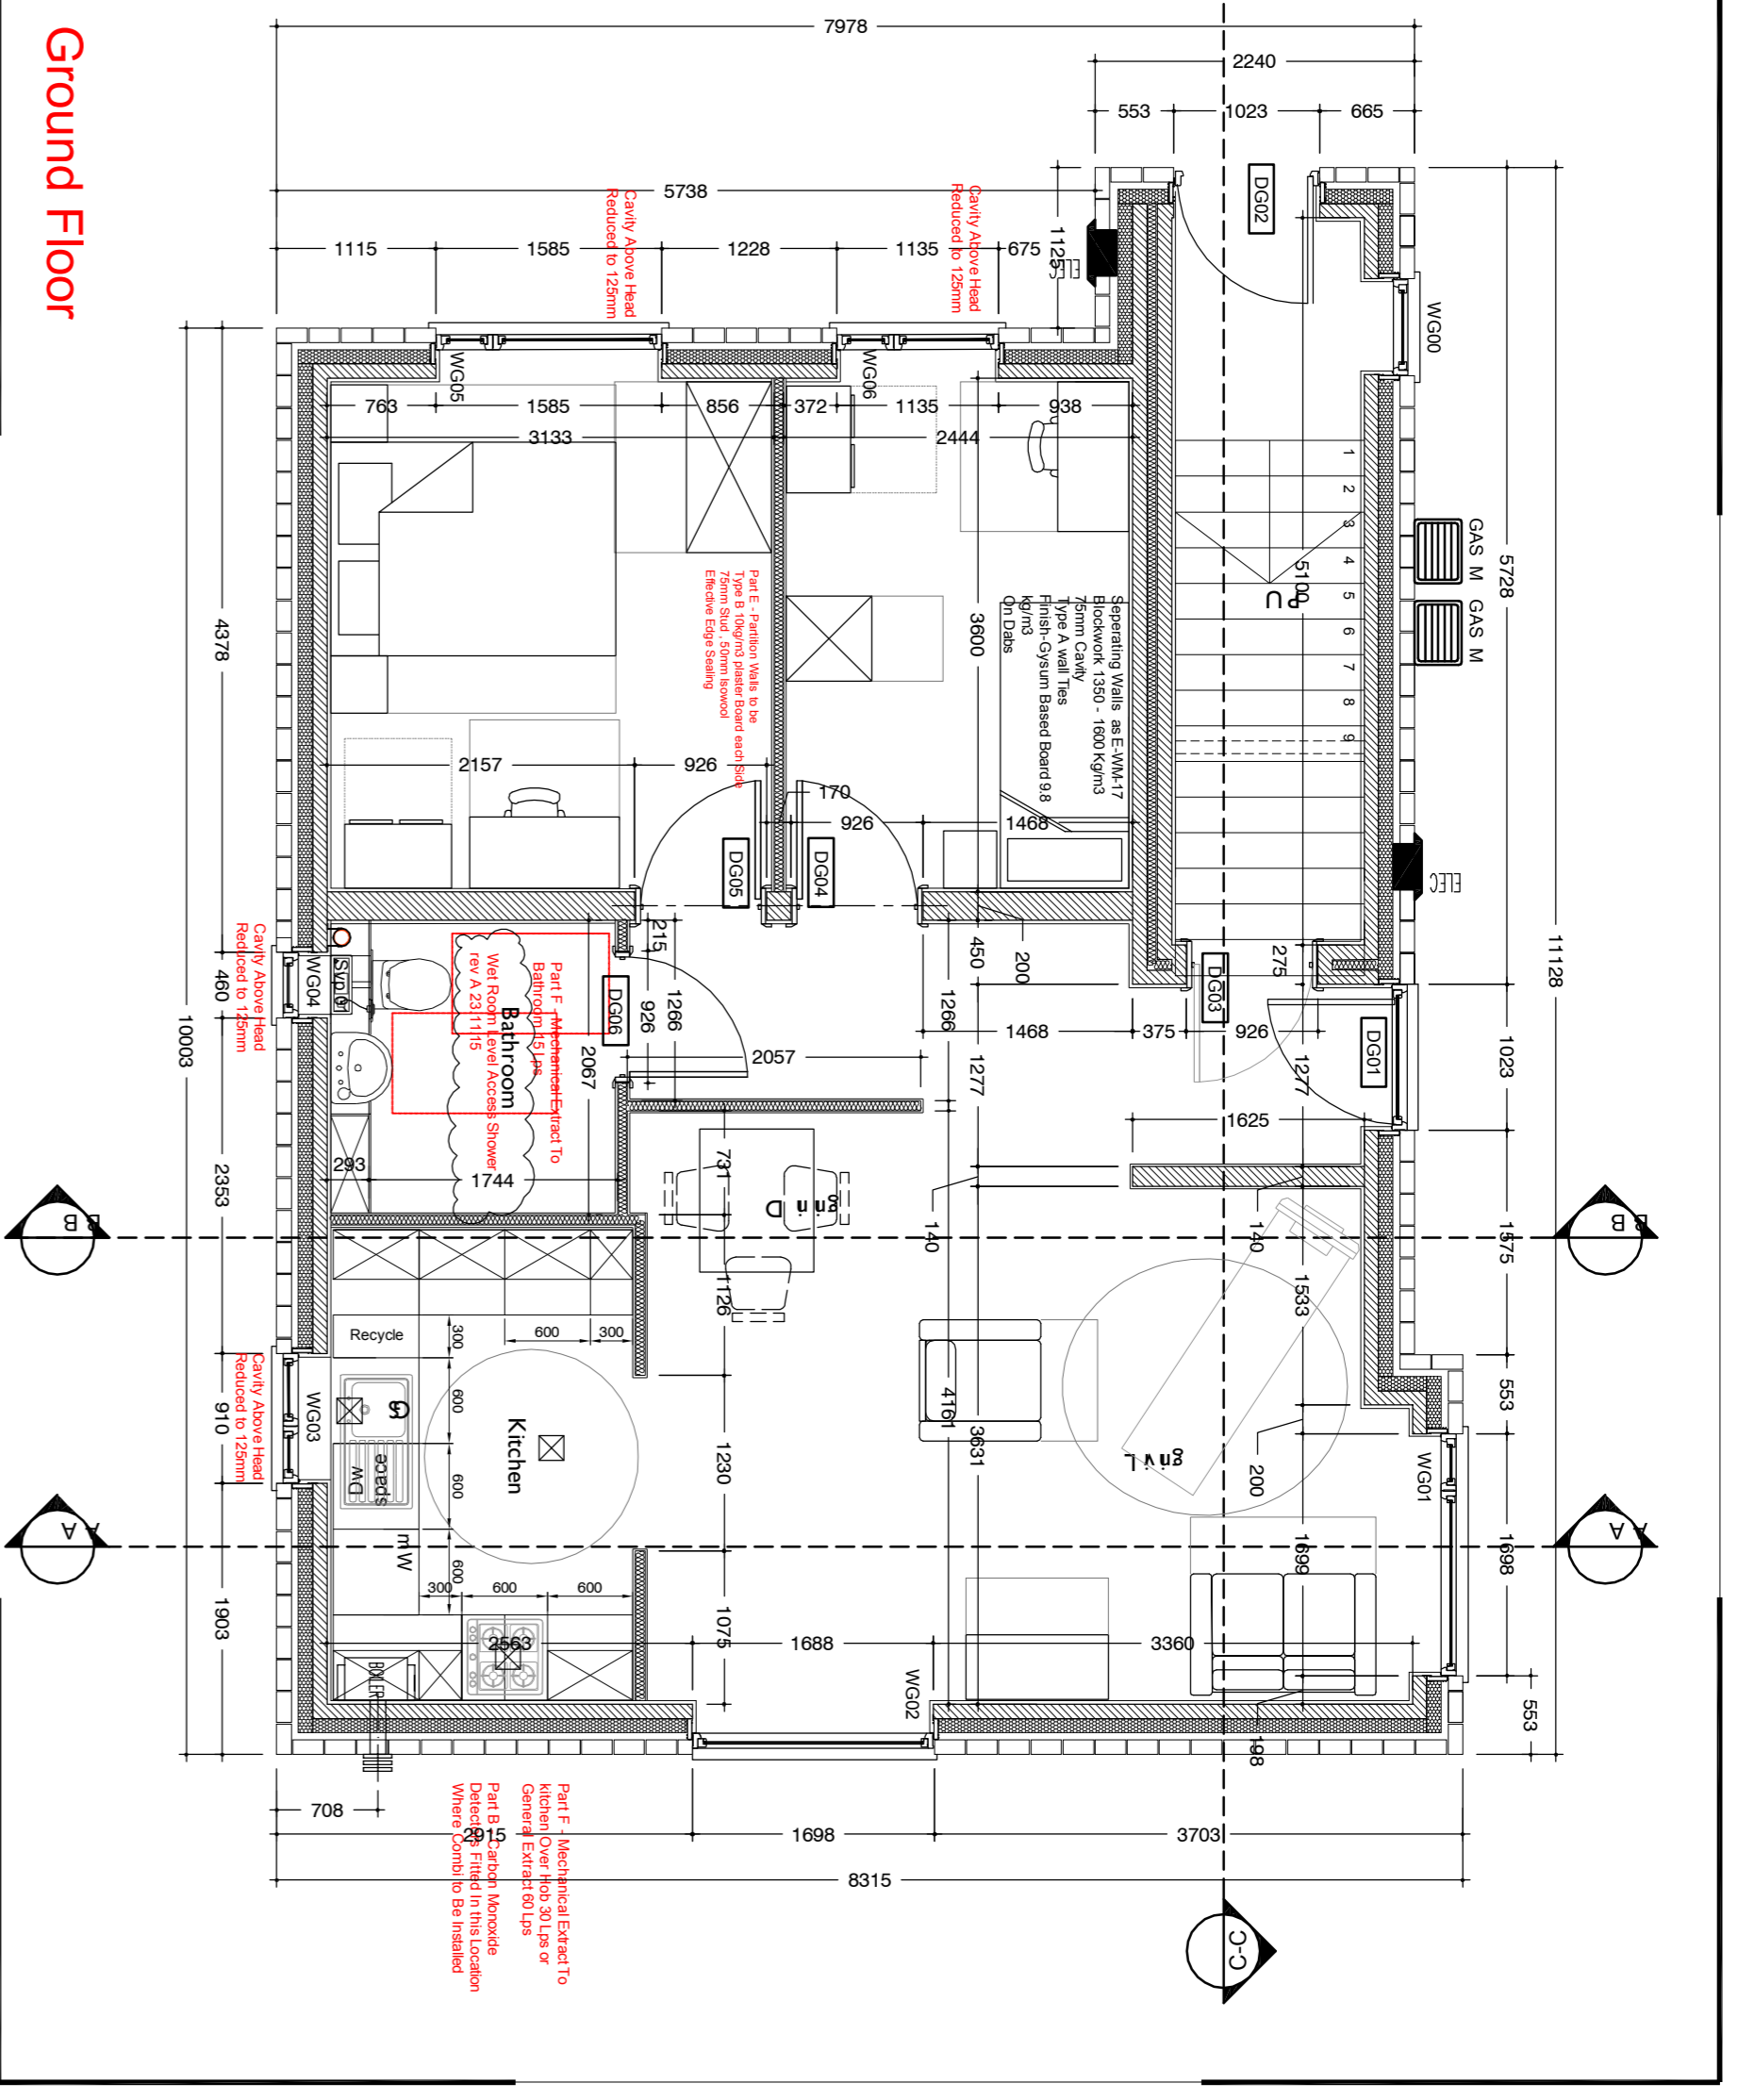

West Elevation

East Elevation


Ground Floor

South Elevation

South Elevation

West Elevation

West Elevation

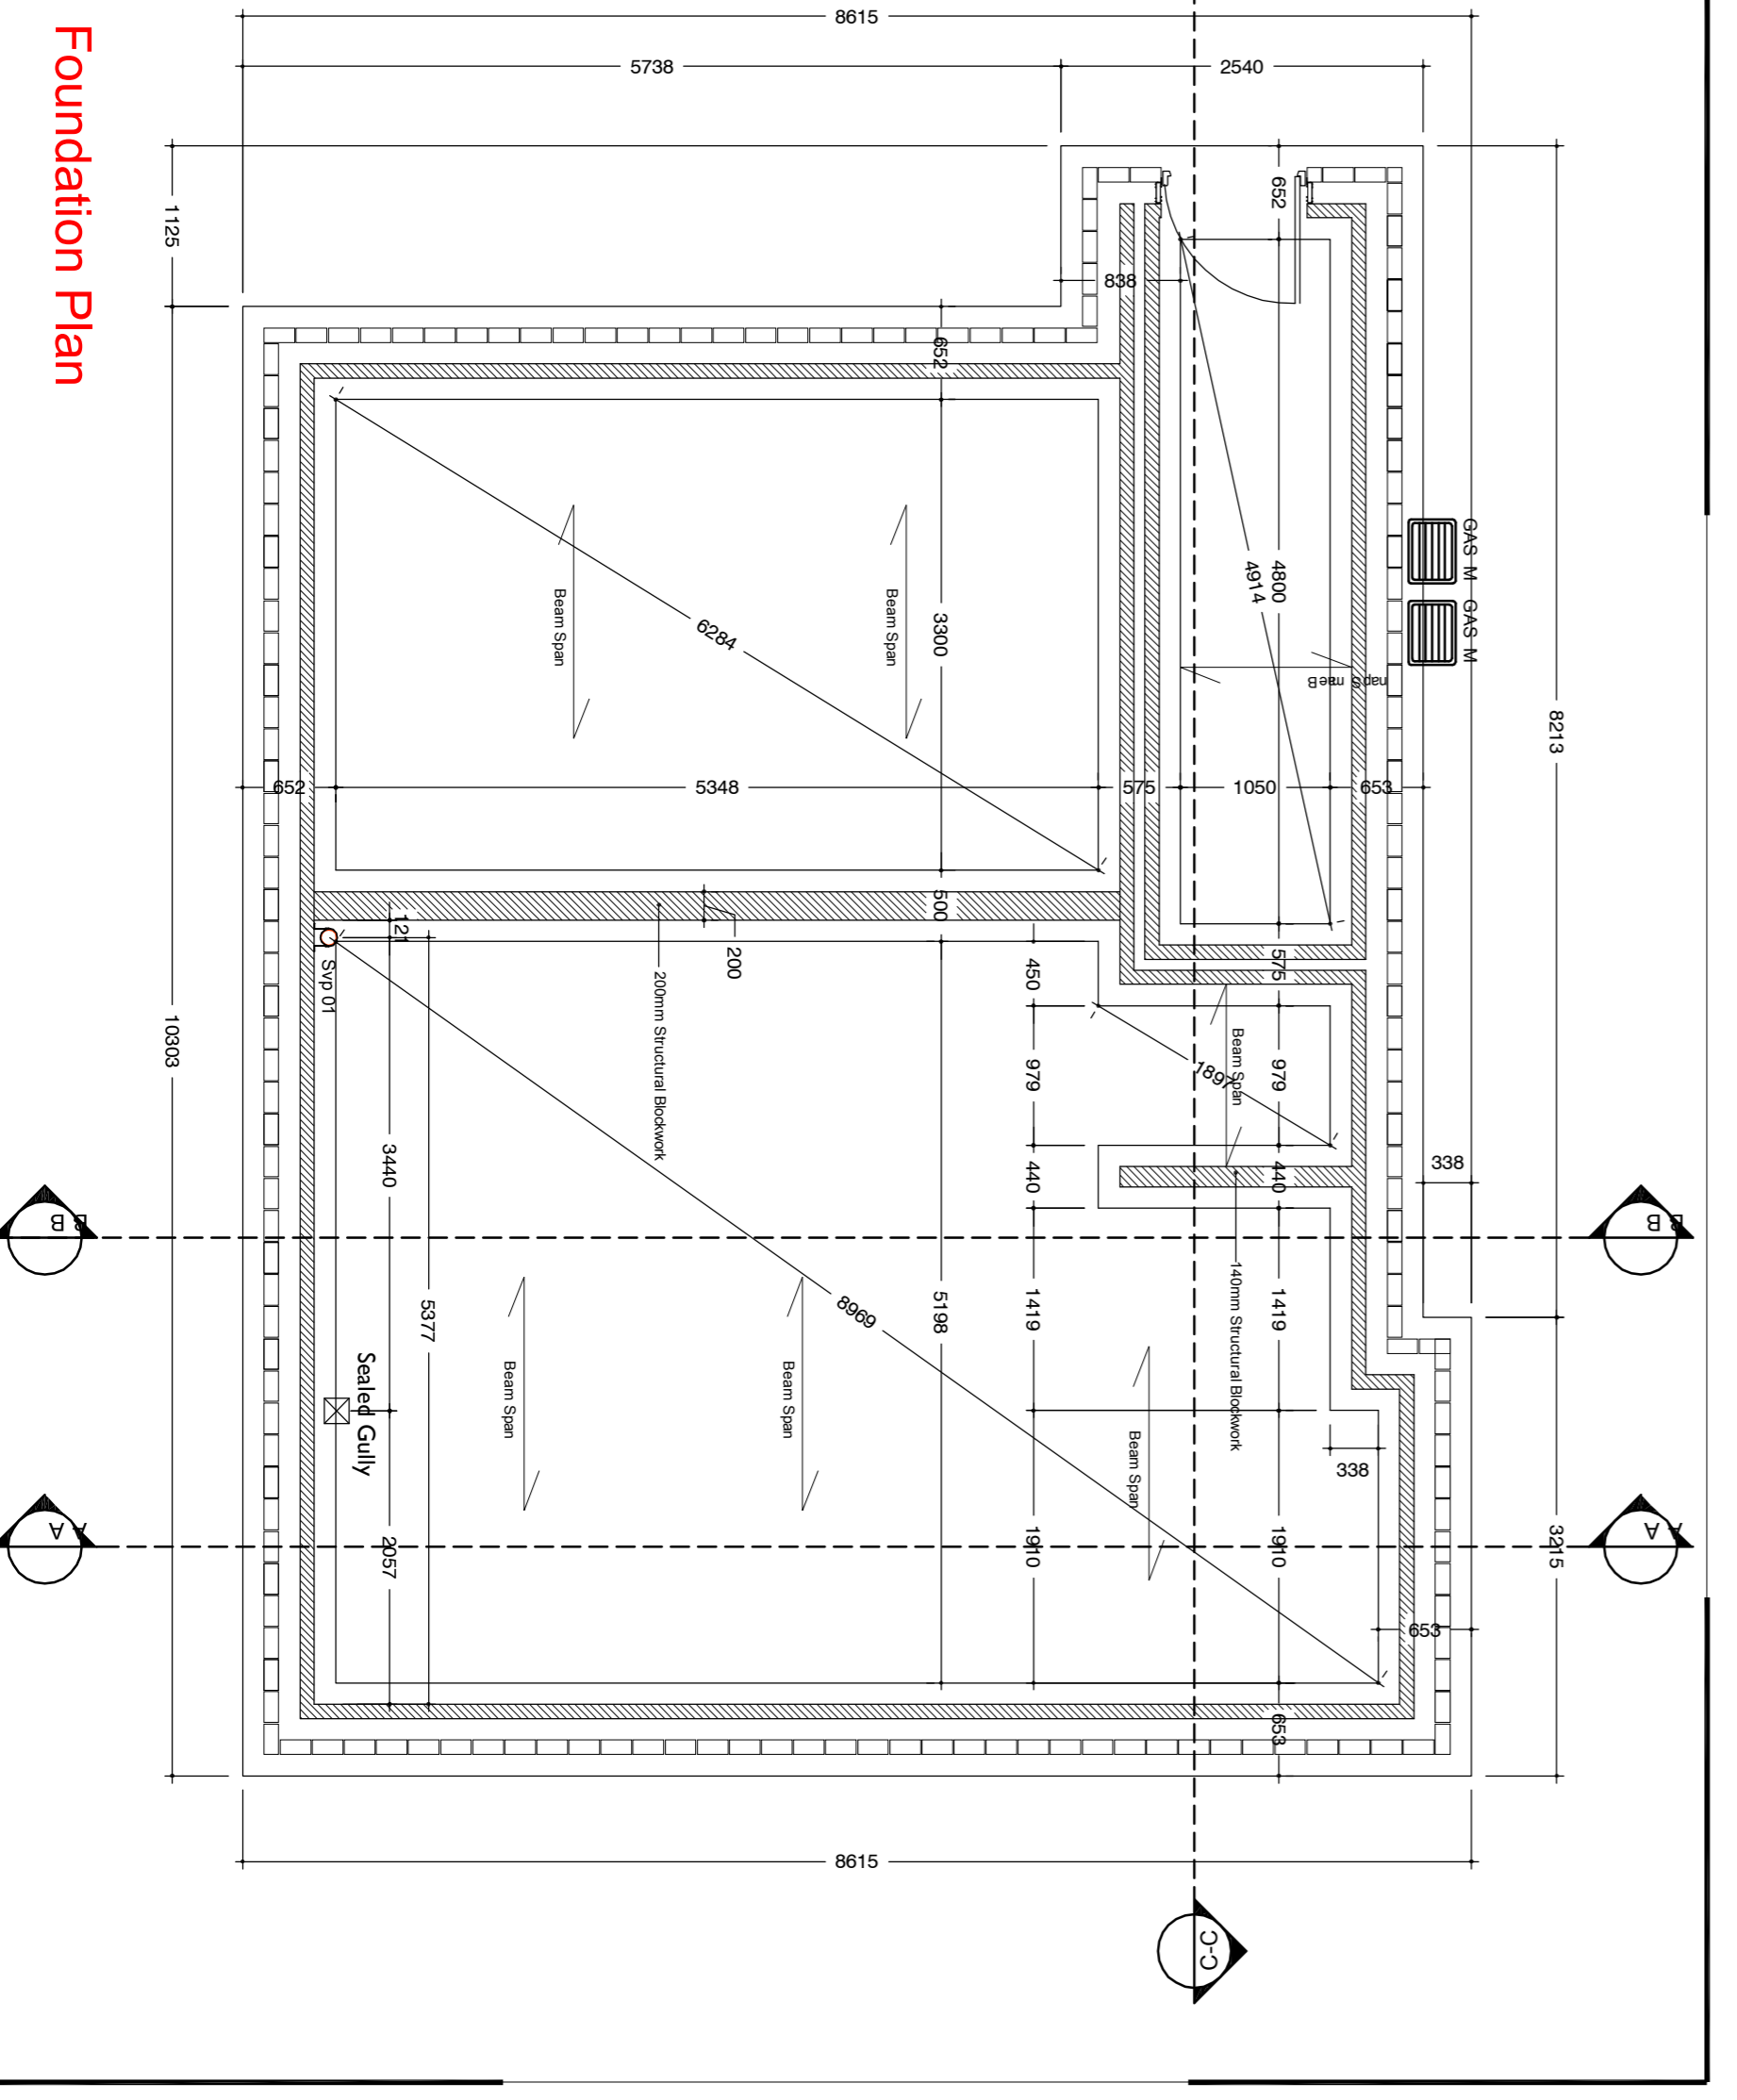


Foundation Plan

South Elevation

East Elevation

West Elevation

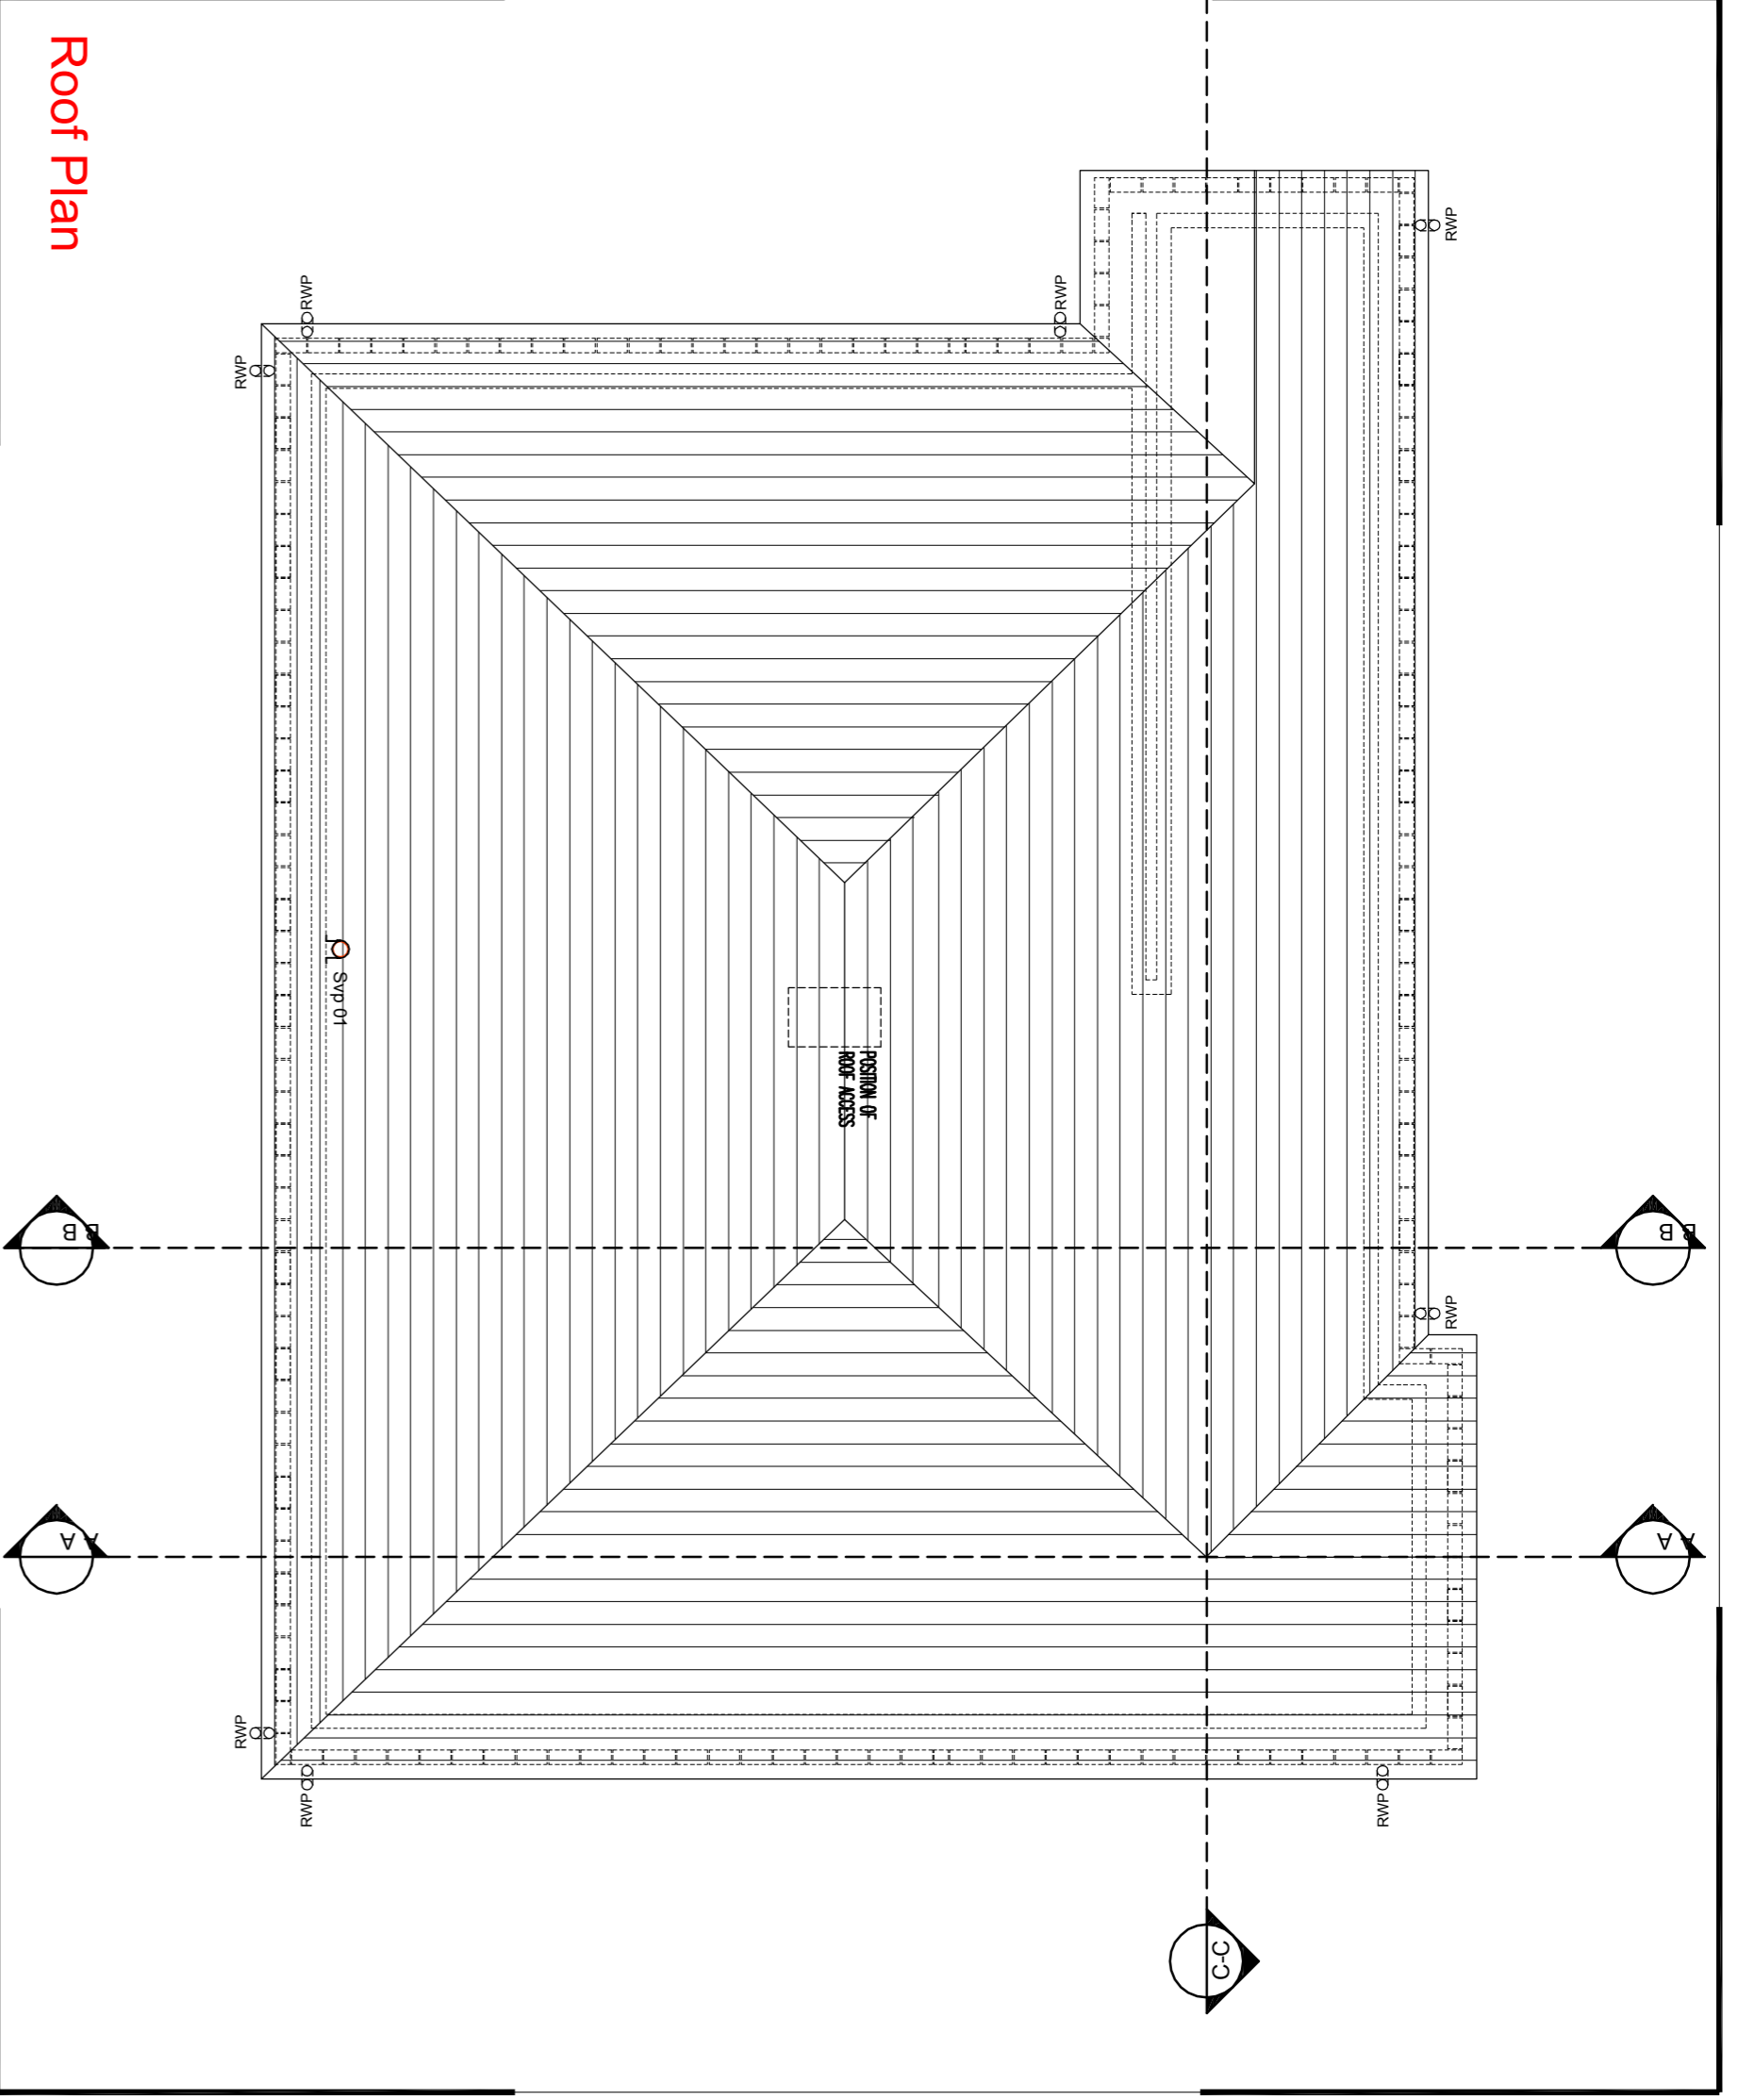

West Elevation

East Elevation


Roof Plan

South Elevation

South Elevation

West Elevation

West Elevation

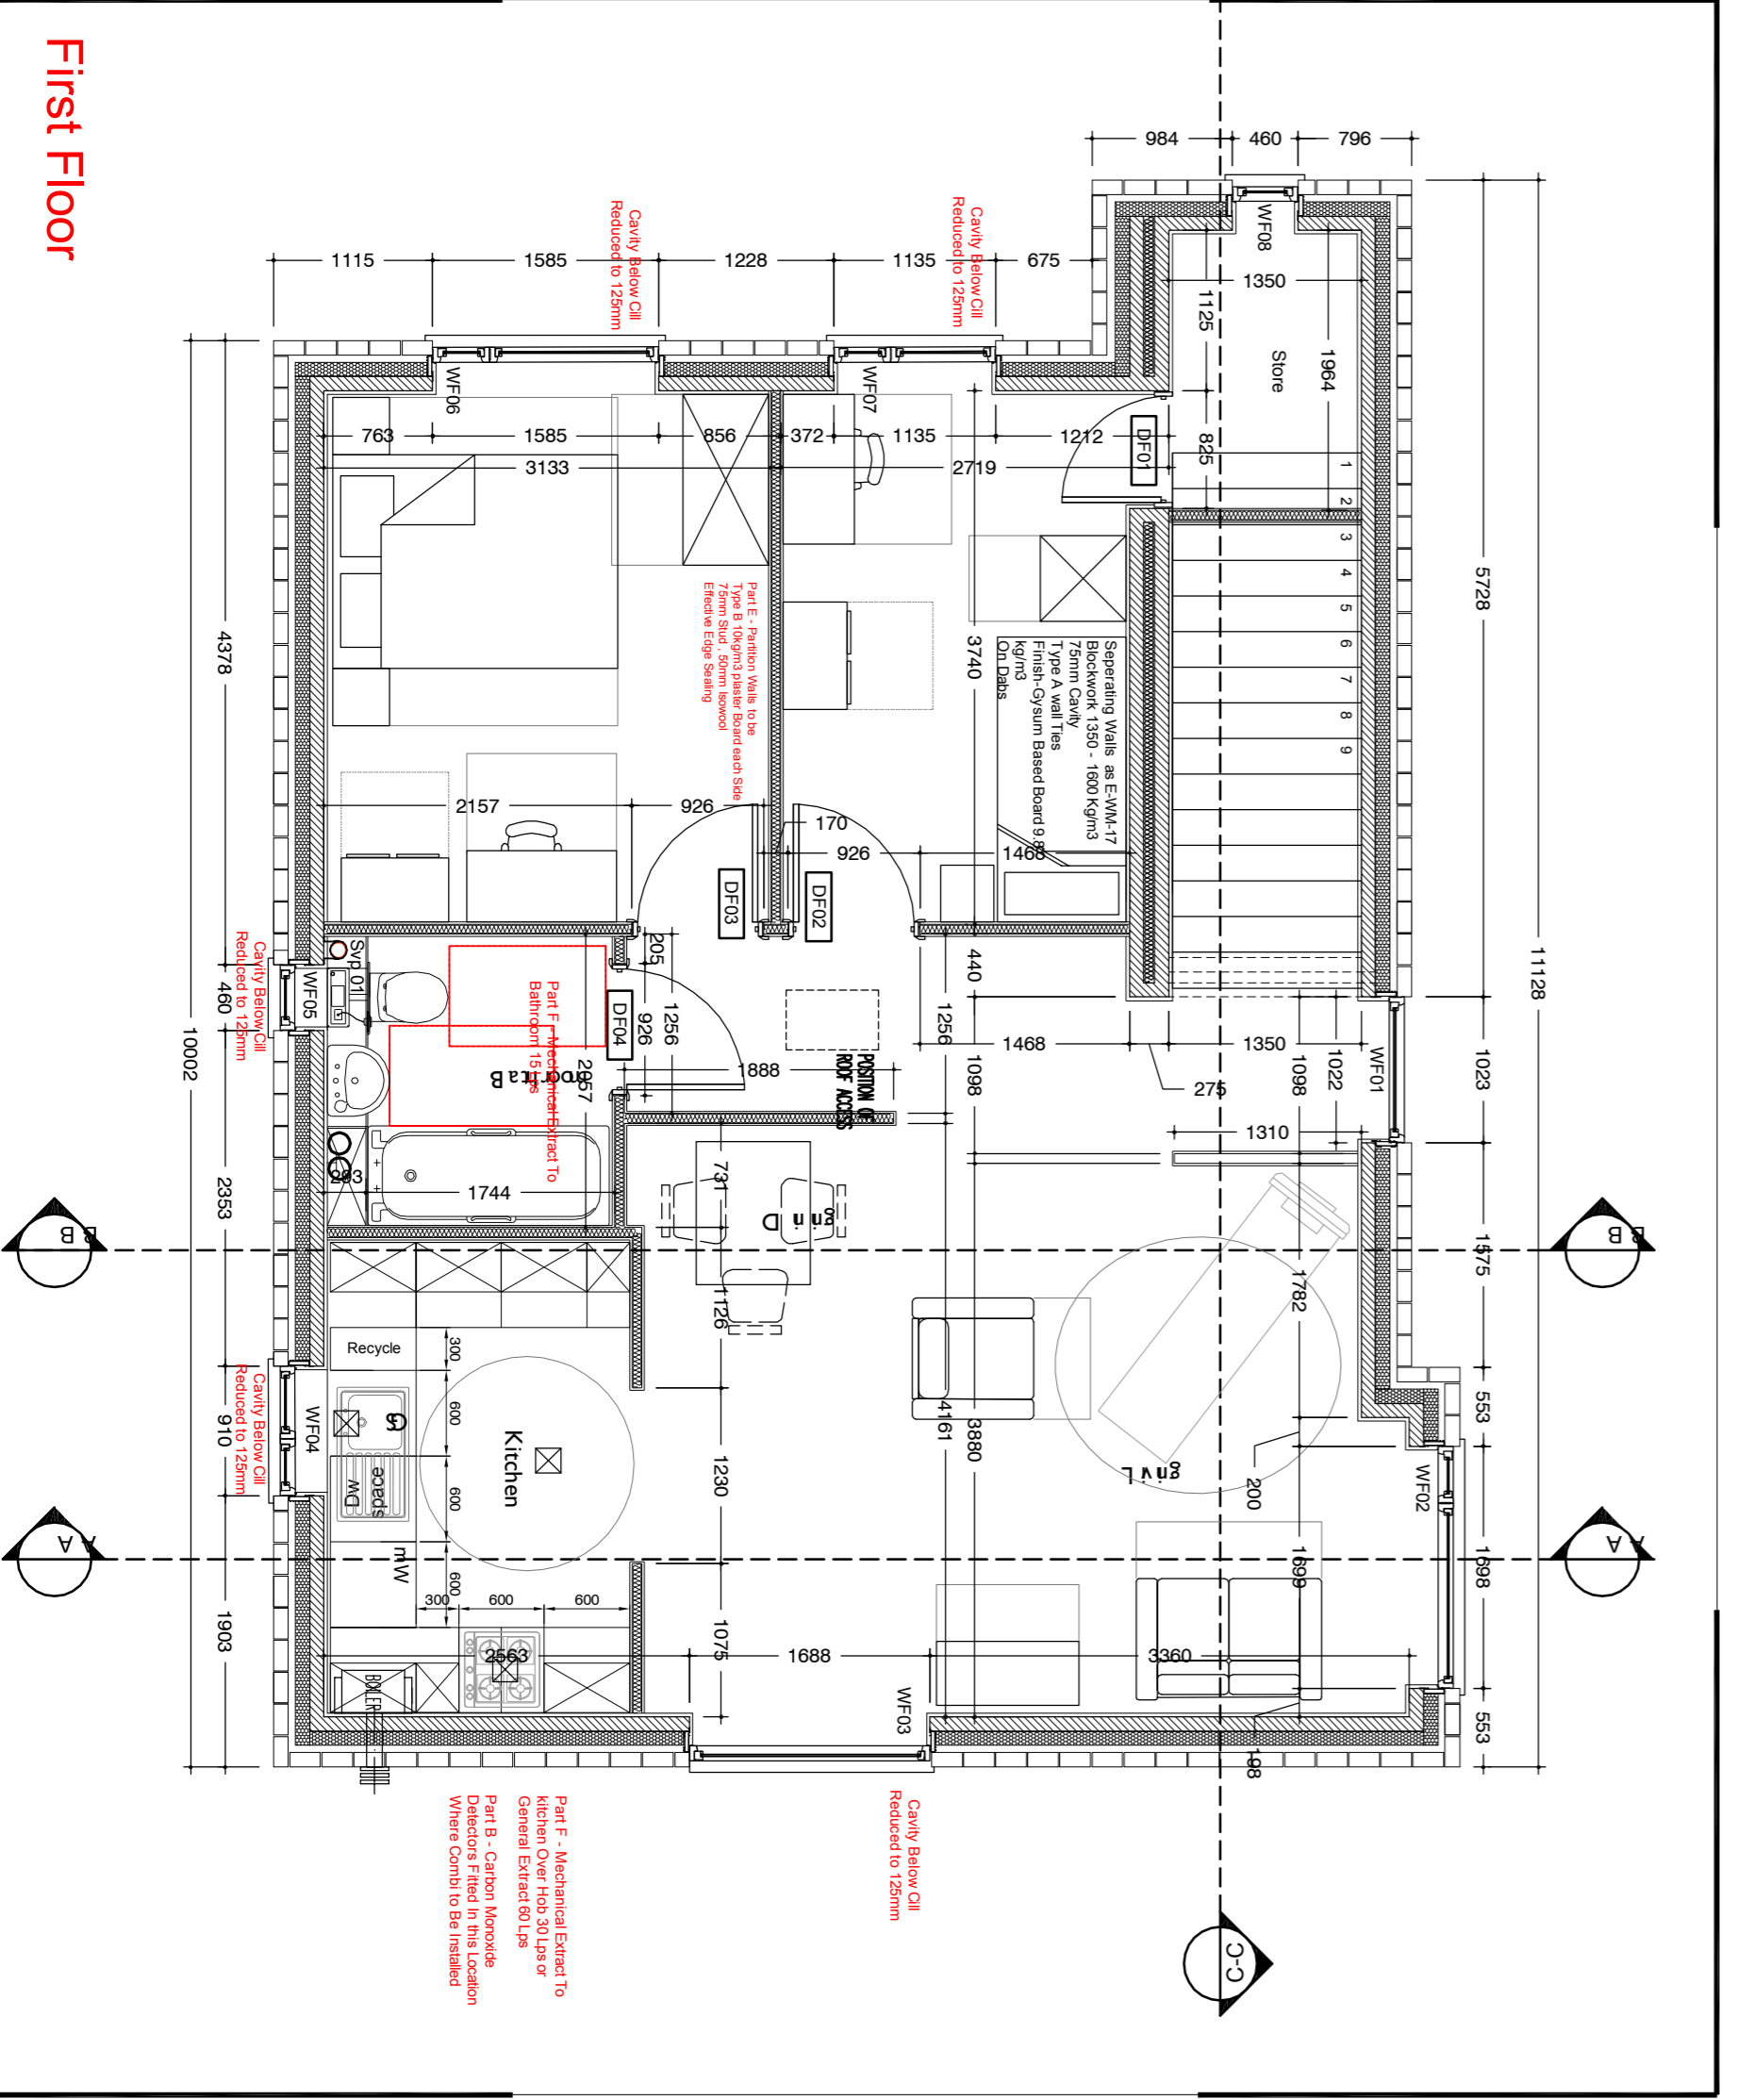

First Floor

South Elevation

East Elevation

Do Not Scale from Drawing. Any discrepancies to be reported to the Architect prior to fabrication or ordering.

CONSTRUCTION NOTES:

EXTERNAL WALLS

100mm facing Brick, 1:1.6 Cement:sand - Brick Sagger to advise as required. 150mm nominal cavity, with stainless steel Double Trangle wall ties at 450mm vert. & 600mm horz. centres with additional ties around all openings. Cavity filled with 100mm Celotex CG 5000. 1400mm kg/m3 dense blockwork inner leaf (Imda 1.05) Or 170mm U value of 0.17 W/m2K 1:1.6 cement:sand mortar bagged off joints to take metal frames to external angle. (system passes with All cavities to be closed using MFR Type V170 Trays closer (equivalent)

EXTERNAL WALLS BELOW DPC

1000mm Class B Engineering Brick, Directly Below DPC. Like to be sulphate Resistant. 1:1.5 of Brick Sagger to advise as appropriate. 100mm nominal cavity filled with mortar to outside ground level. 100mm 7 N/mm Trench block leaf 1:3 cement:sand mortar flash joints. Built up from concrete Strip Foundation Or To Engineers Design Provide pre-cast concrete inlets if drain runs across foundations walls.

DPCs

Provide continuous DPC in brickwork outer leaf min. 150mm above outside ground line. Provide continuous DPC in blockwork inner leaf in block joint above floor. Lap DPC down wall onto DPM. Overlap min. 100mm with & seal to DPM. Provide continuous DPC to external walls above Ground Floor laying to concrete. Ensure Continuation of DPC and DPM - unbroken. Provide continuous DPC to internal blockwork walls at base of slab level. Tmbc Cavity Wall Weep Vent Ref:1.143 Above top of Cavity at base fill + 75mm @ 1000 centres Colour to Match Face Brick

Soil pipes & vent pipes

Soil pipes & vent pipes connected to ridge vents. Intumescent collars fixed to pipes between all compartment floors / walls / ceilings.

Roof Trusses

Roof Trusses: roof trusses designed and manufactured by specialist manufacturer at 600mm maximum centres and pitched as indicated on the drawings. Manufacturer to be responsible for all necessary calculations for submission to the Building Control Authority. 100 x 25mm bracing roof trusses with 150mm x 25mm x 100 x 50mm SW rafters and 75 x 38 SW ceiling joists at 400mm cc finished as described below.

Prefabricated Steel Lintels

Trusses Ref: 845 - 2 Manufacturer - Birtley Building Products Ref: CD 90HD - Code A for Spans 1200mm Code B for 1350mm - 3000mm Galv Steel - Insulation to all Voids, Bearing Length 150mm unless determined otherwise By Engineer.

GENERAL NOTES

All internal doors will be 30 minutes fire resistant, with self-closers, intumescent strips and odd smoke seals, except: a) Shower doors which will not be fire rated. b) All internal doors set to be solid core. Safety Glazing to BS 6206: 1989 will be provided to all glazing below 800mm above floor level. Shower and WCs will have ducted mechanical ventilation to provide: i) min. 15 litres per second operation with 15 minutes overrun. ii) WCs: extraction at min. 3 air changes/hr intermittent operation with 15 minutes overrun. Getting to the underside of the roof trusses to be 50mm penetrations not to be larger than permitted in Section 10 of Approved Document B of the Building Regulations

Electrical Layout

All electrical works shall be in accordance with BS 7671: 2018 and shall be Building Regulations and certified prior to completion. Radiator Pipes and Gutters: Radiator/Circulator pipes and gutters, mainly system (or approved equivalent). Gutters generally to be 112mm half round. Down pipes generally to be 68mm round section, all fixed in accordance with manufacturers recommendations and specifications. Connectors, bonds, stop valves, stop ends etc. Thresholds to the principal entrance to be provide with level access Detail. Entrance Doors to be minimum 1022 5mm double glazed 'low' Hard Coat, Solar Energy Light Transmittance 0.80

Pre-completion Testing

All pre-completion testing to be carried out on the day of completion, to be verified as determined by SAF

Project information including CEAD logo, job title 'South Tyneside Homes Edhill Avenue', and drawing title 'Proposed Apartment GA PLANS'.

Table with 4 columns: REVISION, DATE, DESCRIPTION, CHECKED. Includes revision 14.06 ED.PL.04 and drawing status P.

Not to be reproduced without permission. Copyright CEAD Ltd. STATUS: D-Draft, R-Review, P-Planning, T-Transfer, C-Construction, B-As-Built