


Do Not Scale from Drawing. Any discrepancies to be reported to the Architect prior to fabrication or ordering.

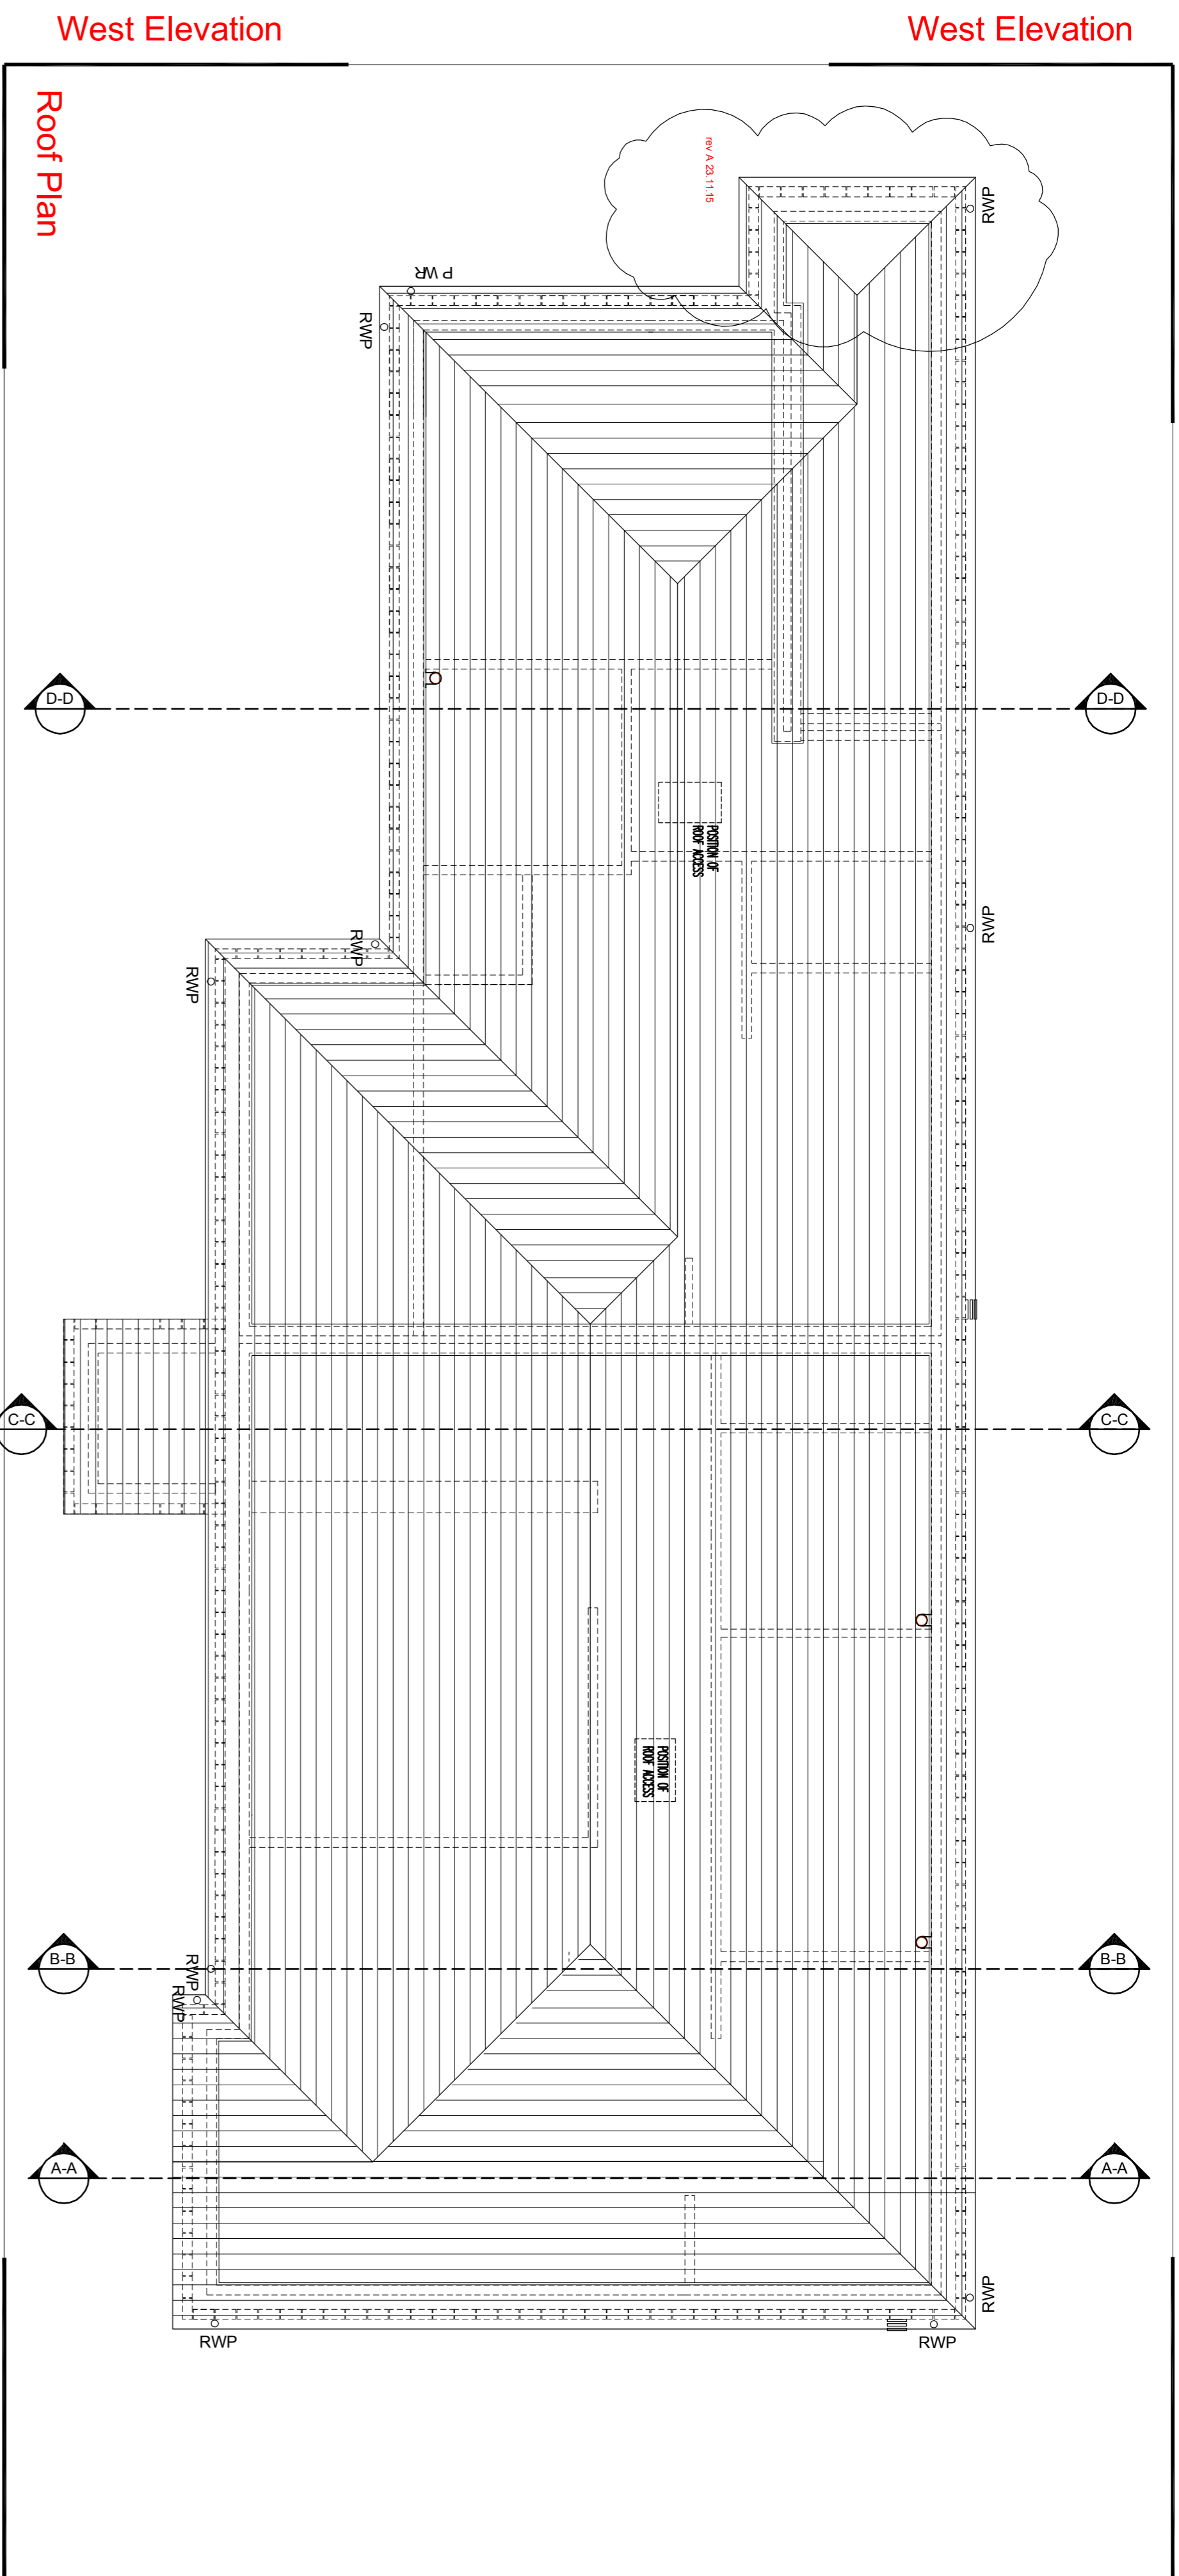


West Elevation

Roof Plan

South Elevation

South Elevation

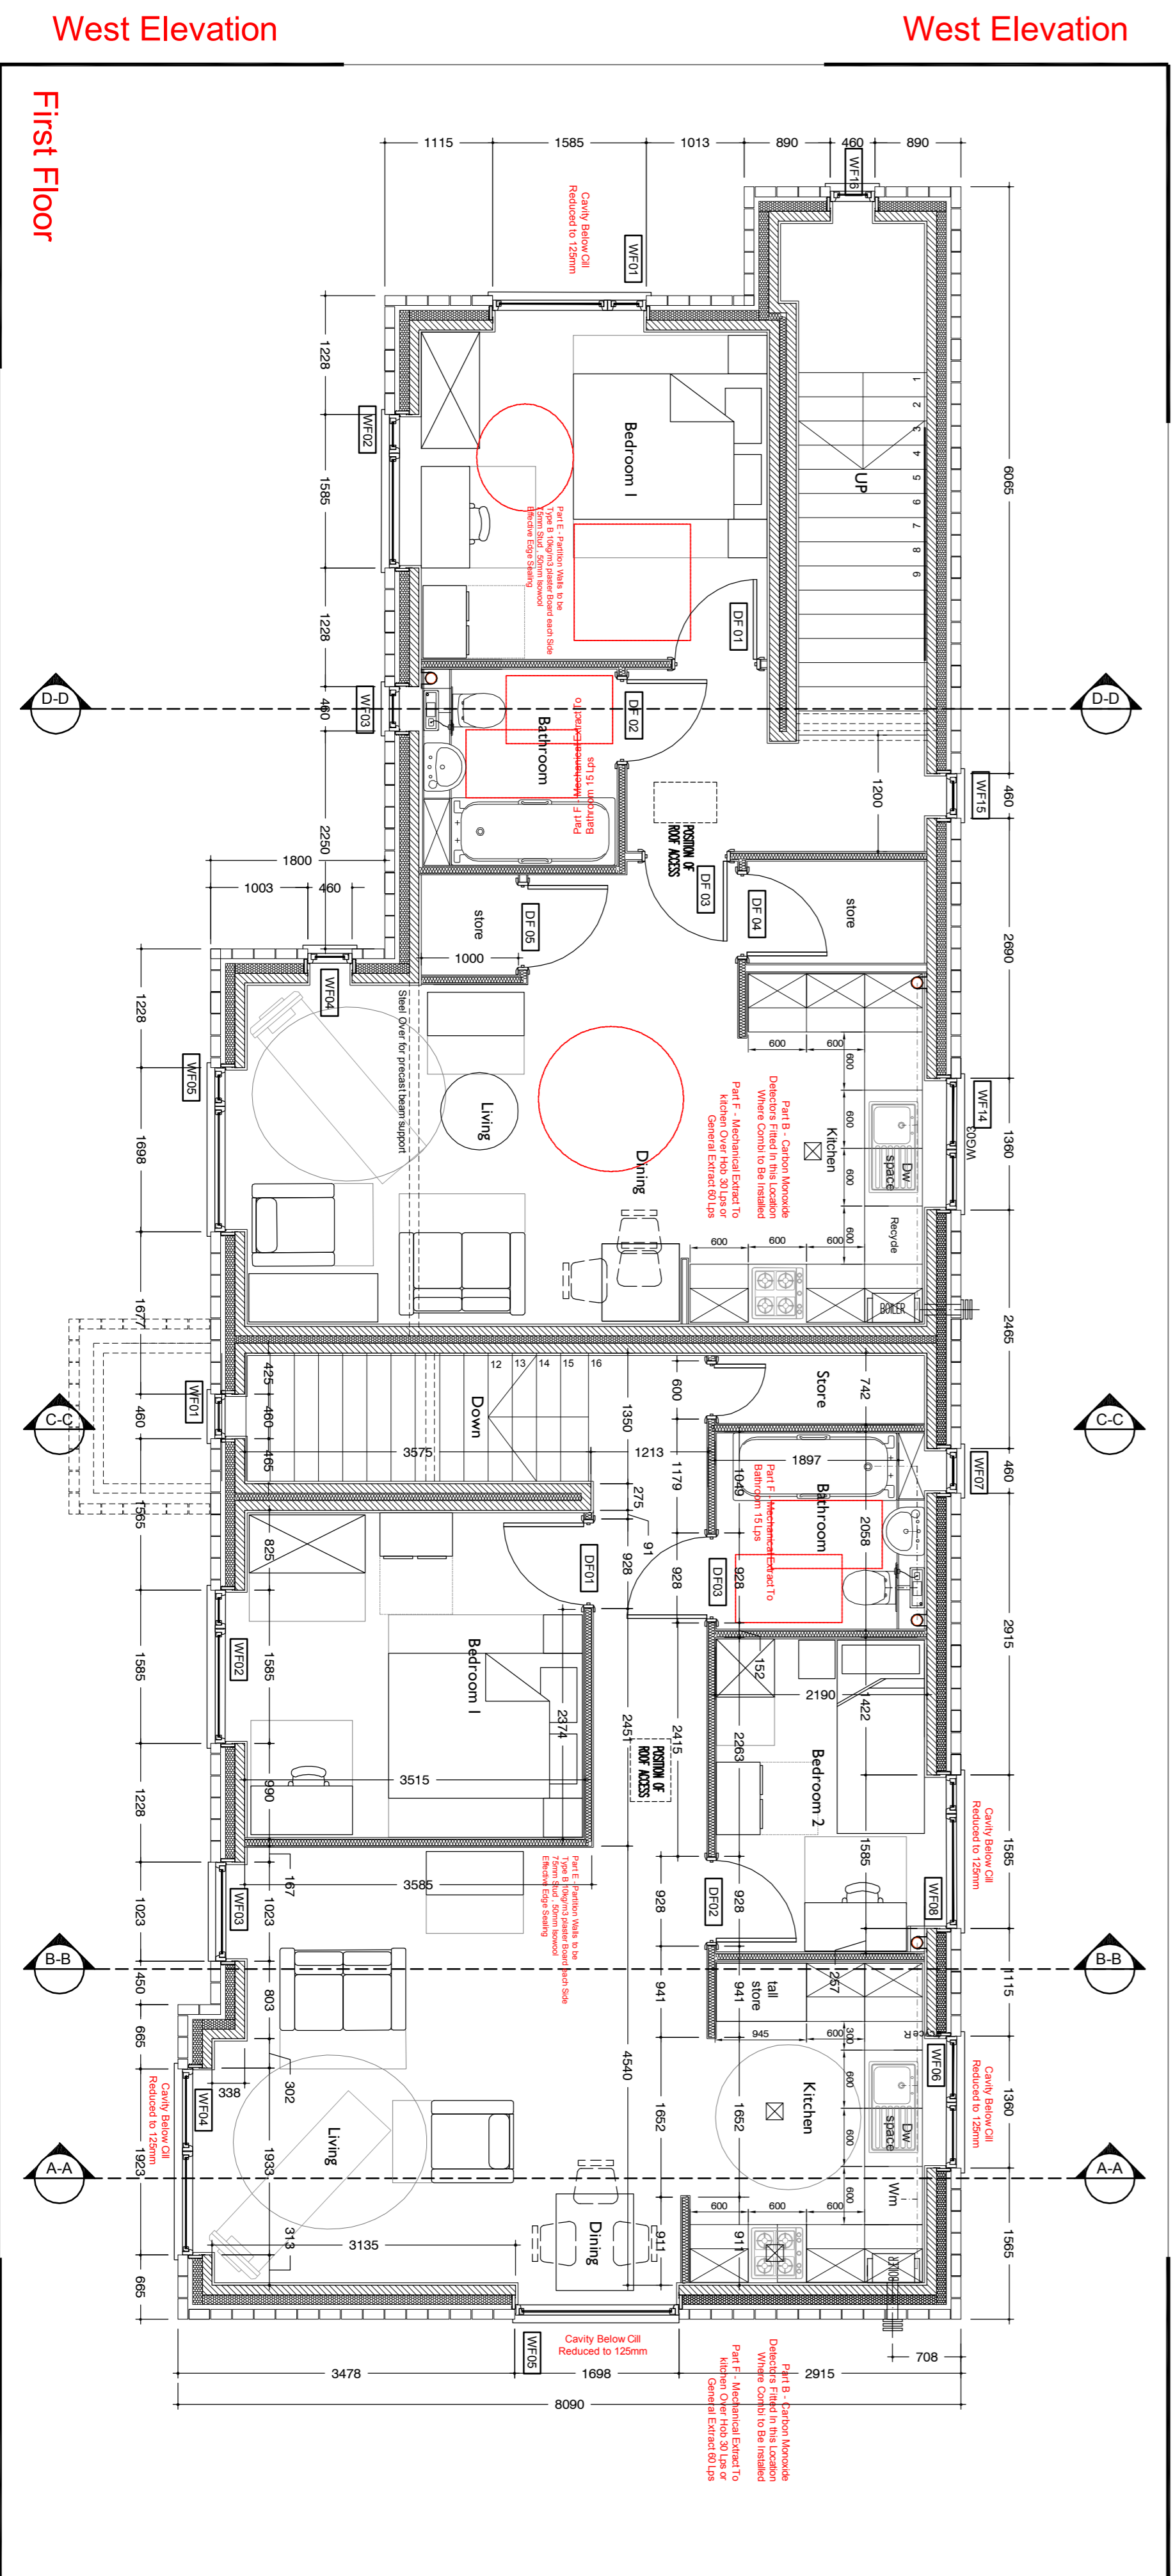

West Elevation

North Elevation

North Elevation

West Elevation

First Floor

South Elevation

South Elevation

PLOT 5 AND 6 upper

PLOT 3 AND 4 upper

not avh Etsa F

not avh Etsa F

not avh Etsa F

not avh Etsa F

REVISION	DATE	DESCRIPTION	CHECKED

 <p>CEAD Community Environment Architecture Delivery</p>	
<p>JOB CLIENT South Tyneside Homes Wark Crescent</p>	
<p>DWG TITLE Proposed Apartment First Floor - Roof Plan</p>	
PROJECT NO.	DRAWING NO.
14.06	EA.PL.06
DRAWN: PM	CHECKED: RM
SCALE: 1:50	DATE: MAY 15
REVISION: STATUS	P

Not to be reproduced without permission. Copyright CEAD Ltd.
STATUS: D=Draft R=Review P=Planning T=Transfer C=Construction B=As-Built