



Do Not Scale from Drawing. Any discrepancies to be reported to the Architect prior to fabrication or ordering.

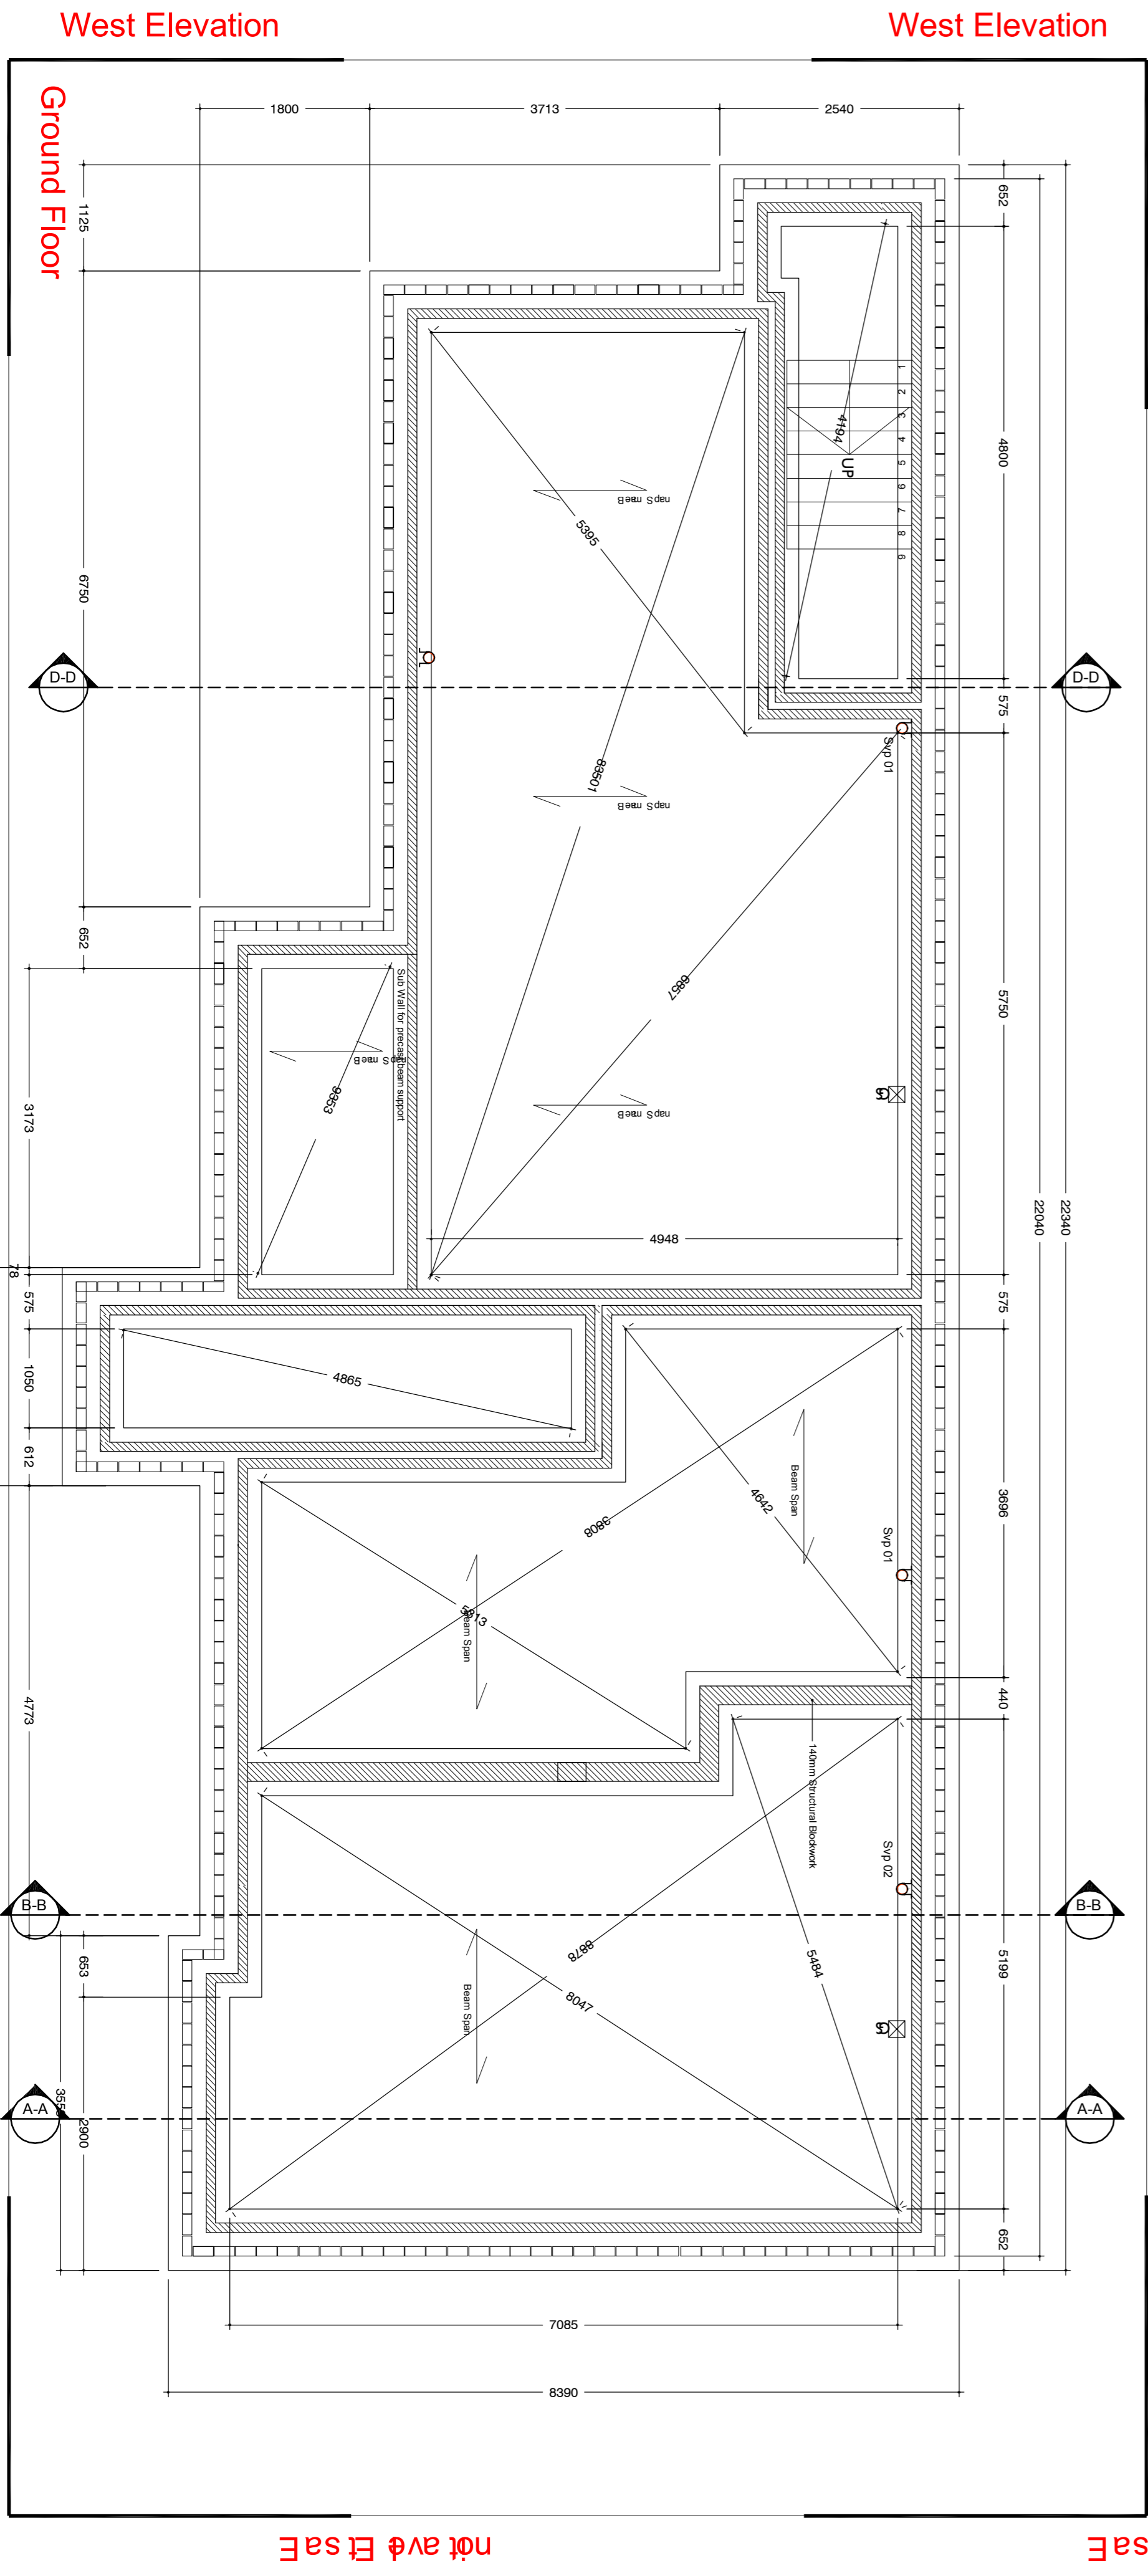

REVISION	DATE	DESCRIPTION	CHECKED

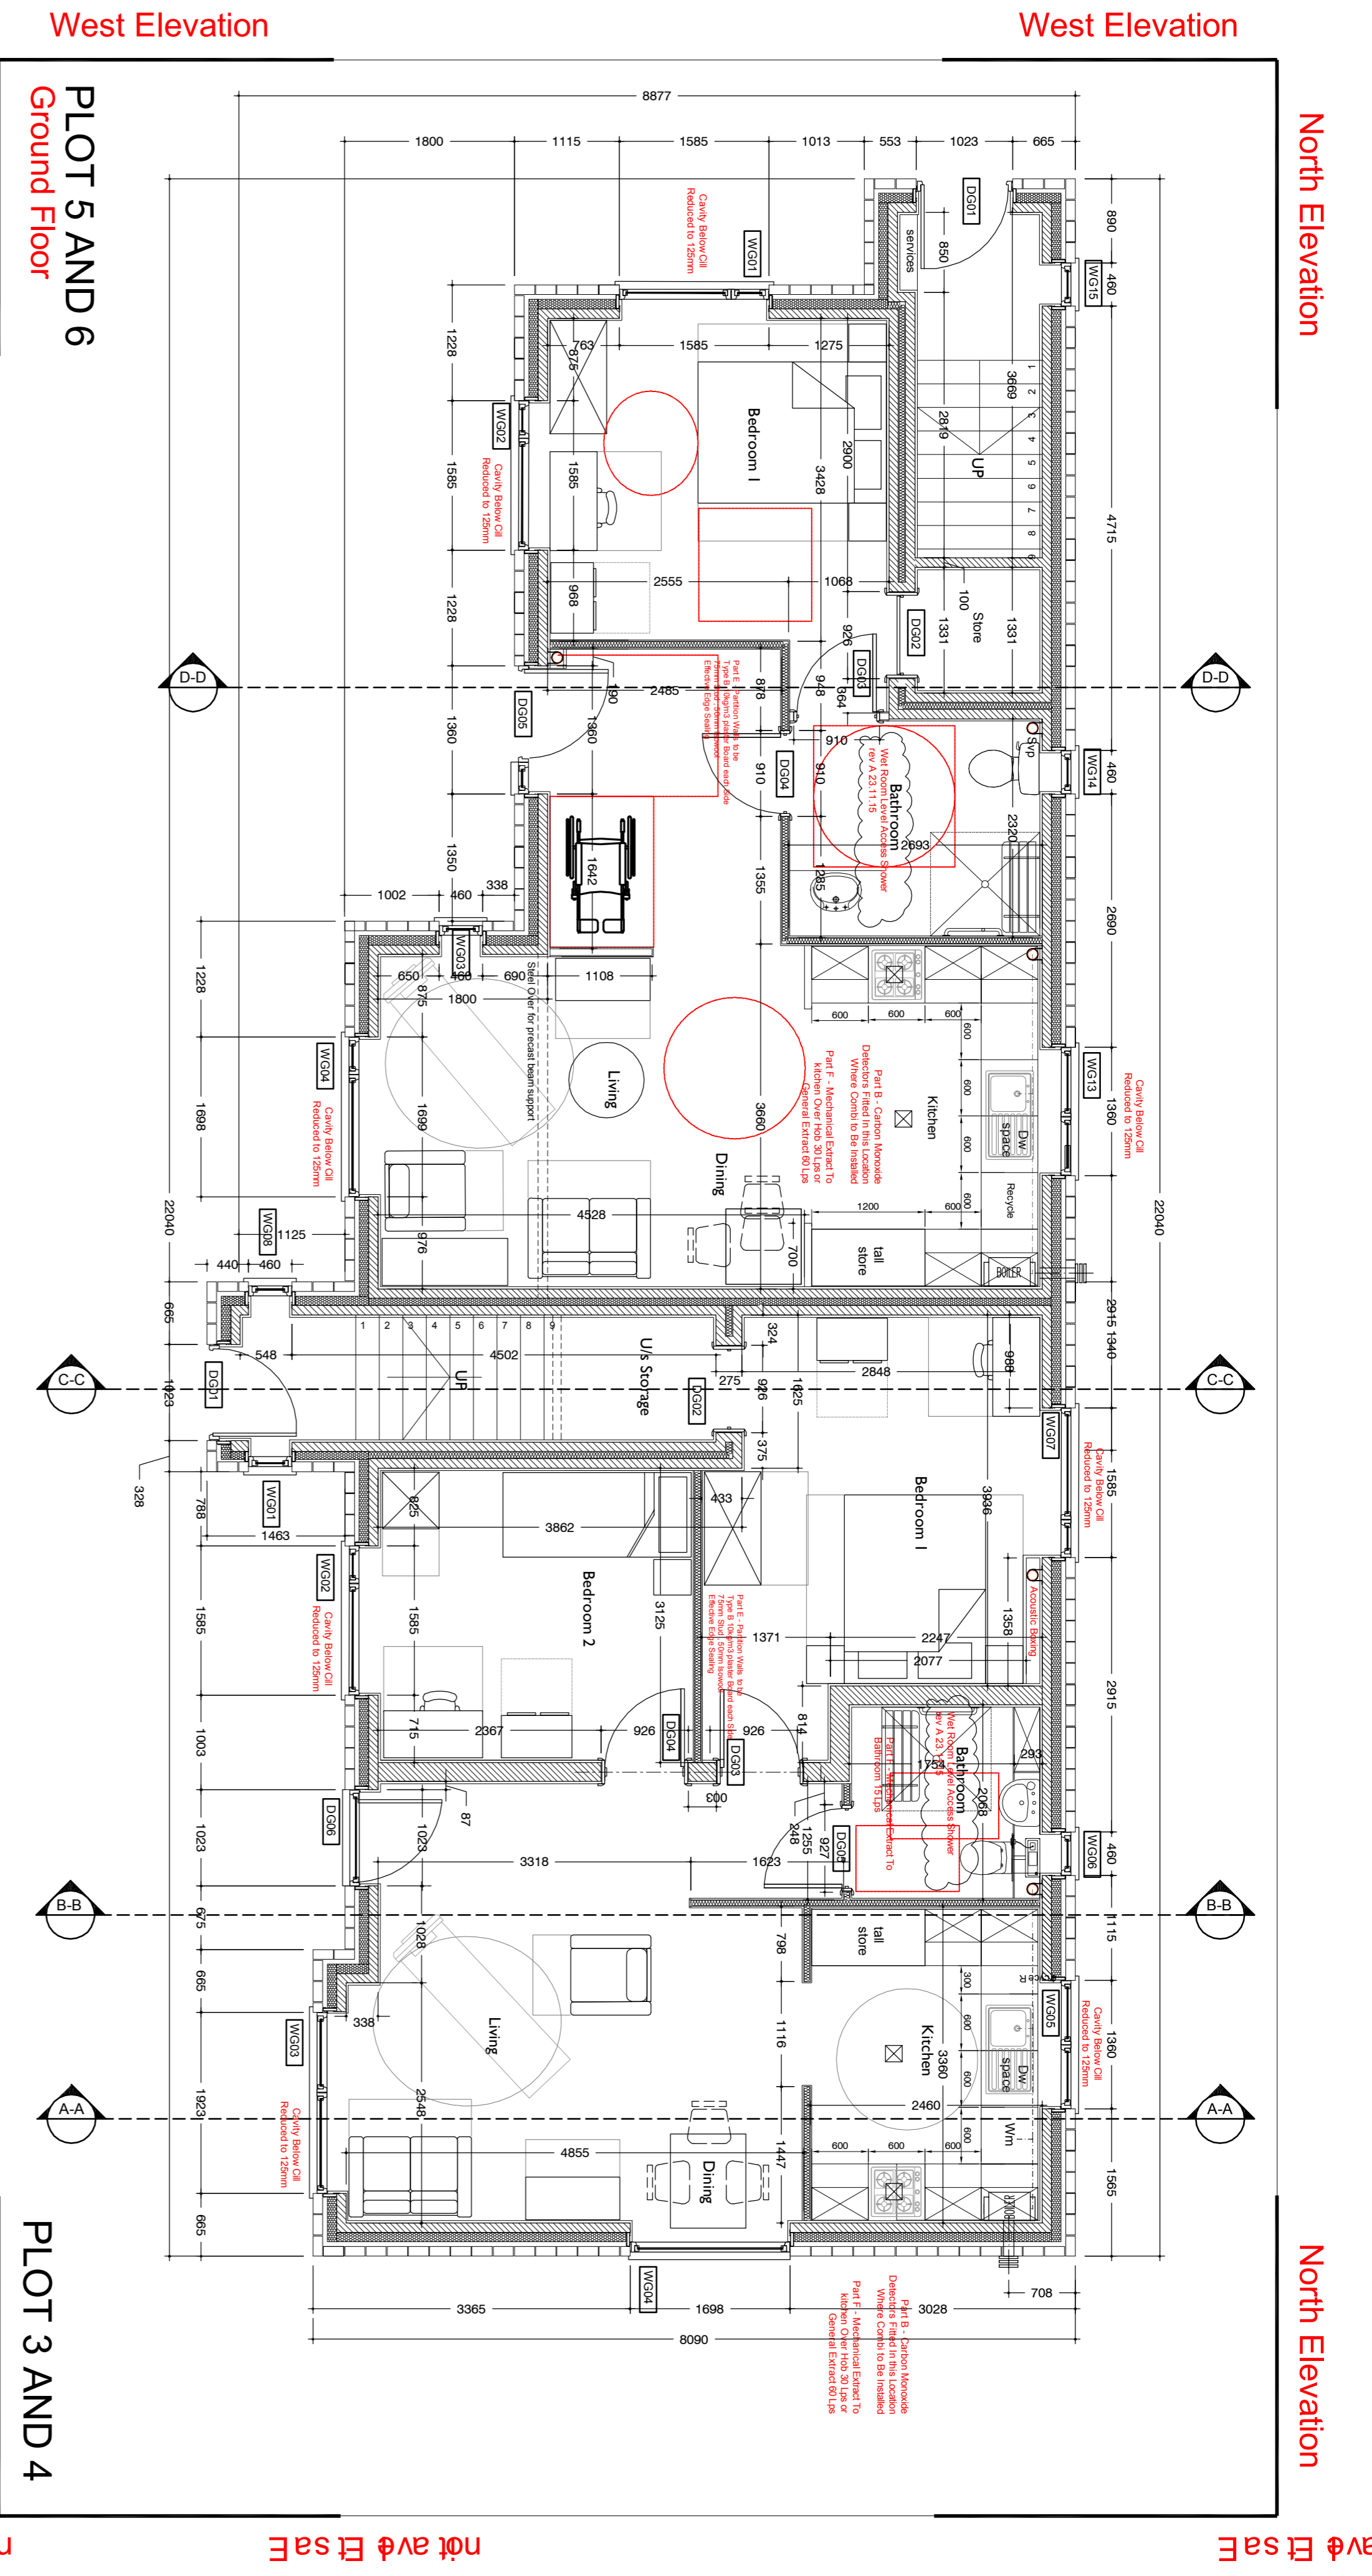

JOB CLIENT
South Tyneside Homes
Wark Crescent

DWG TITLE
Proposed Apartment
Foundation and Ground Floor

PROJECT NO.	DRAWING NO.	REVISION	STATUS
14.06	EA.PL.05	P	

DRAWN	CHECKED	SCALE	DATE
PM	RM	1:50	MAY 15

Not to be reproduced without permission. Copyright CEAD Ltd.
STATUS: D=Draft, R=Review, P=Planning, T=Tender, C=Construction, B=As-Built