


confidential
Keith Watmuff
Spring Petroleum
Jun 11, 2011 04:36



REV	DATE	COMMENT	CAD

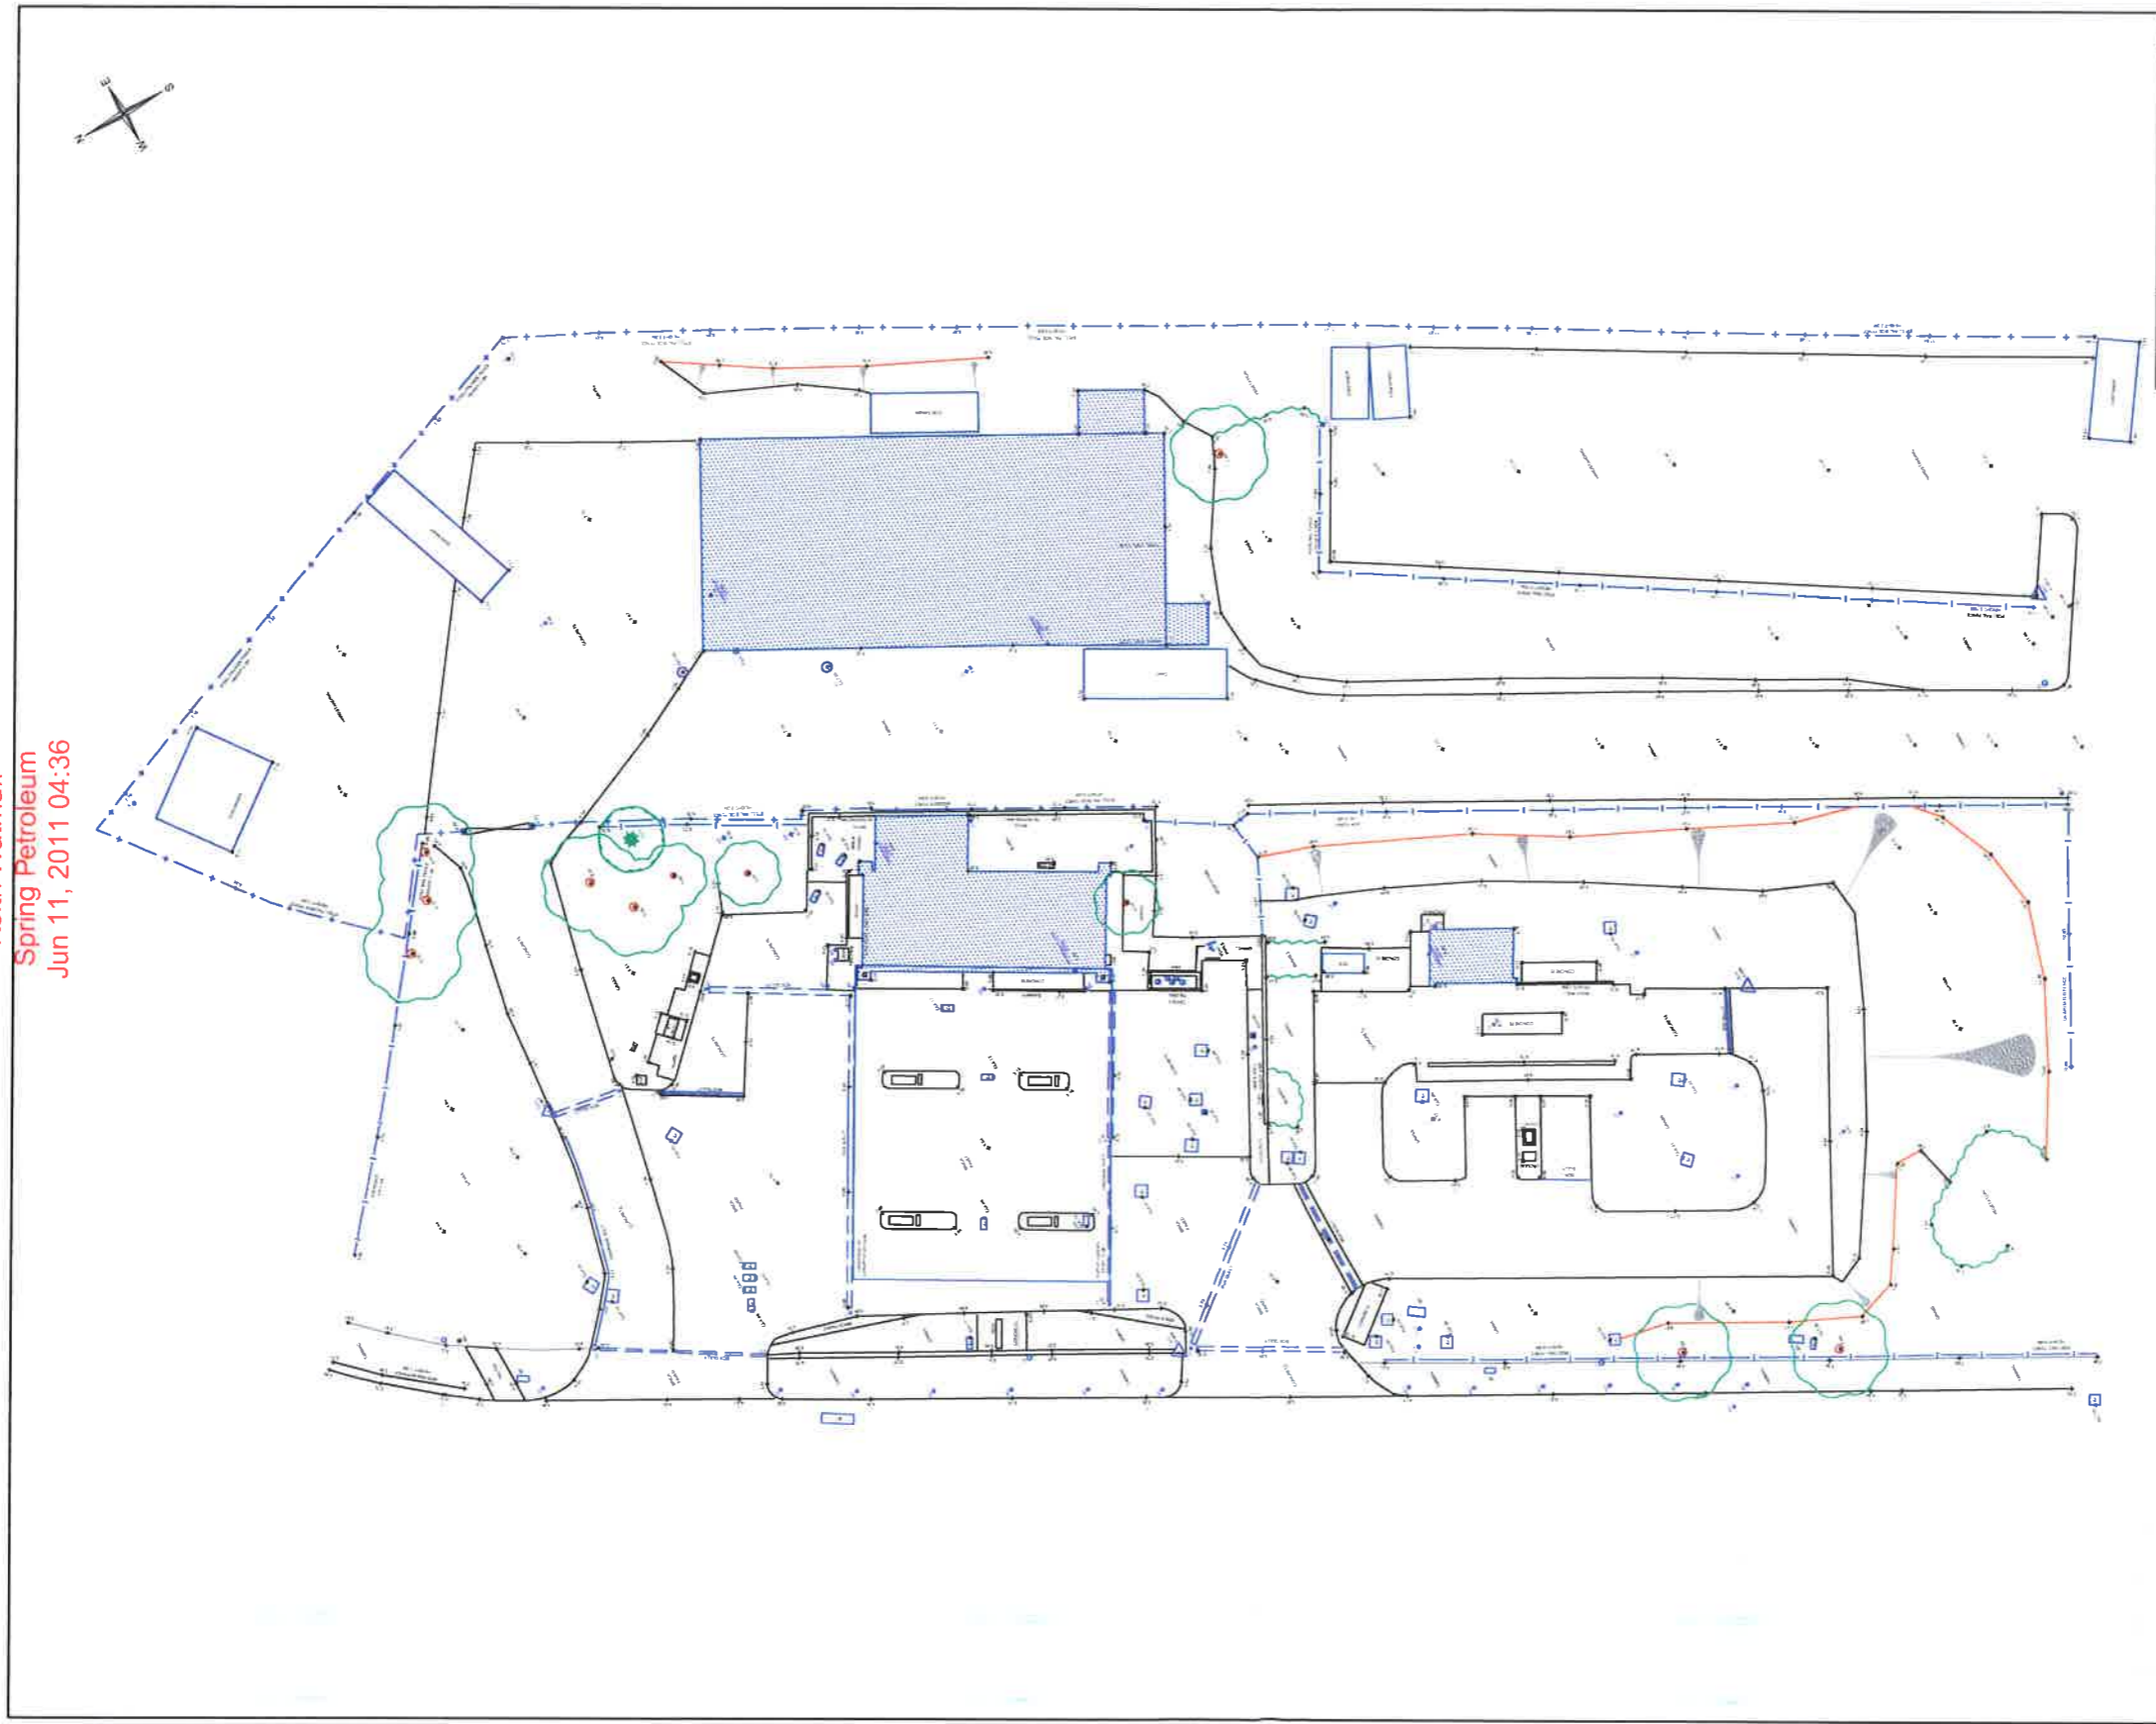

DISCLAIMER	NOTES	KEY	TITLE: SITE LAYOUT PLAN	SITE: SIMONSIDE SERVICE STATION
			PROJECT: 93749 00	CLIENT: ESSO PETROLEUM COMPANY LTD
<p>NOTE: THE LOCATIONS OF ANY UNDERGROUND SERVICES SHOWN ON THIS DRAWING HAVE BEEN DETERMINED USING ELECTROMAGNETIC METHODS. THE DRAWING HAS BEEN CHECKED AGAINST THE RECORD DRAWING AND IS GUARANTEED TO BE CORRECT. LIMITATIONS OF THIS DRAWING SHOULD BE REALISED AND NO GUARANTEE CAN BE GIVEN THAT ALL SERVICES HAVE BEEN IDENTIFIED. DRAWING WILL MAKE THIS DRAWING INVALID. THIS DRAWING SHOULD BE USED IN CONJUNCTION WITH THE RECORD DRAWING. THIS DRAWING SHOULD BE USED AS A GUIDE ONLY. CONTACT ARCADIS UK IN CASE OF ANY QUERY.</p>			DATE: 01/09/10	PRINT: A3
			DRAWN BY: MRF	REV: -
			DRG No.: 937490004-CAD	FIGURE 2

confidential
Keith Watmuff
Spring Petroleum
Jun 11, 2011 04:36

