




South Tyneside Council

Economic Regeneration

Projects		Drawing Title	
Site Plan		Jarrow Toan Hall	
Project Code		Drawn By	PM
		Checked By	
		Scale 1:	500
Rev	Date	OS Ref	Chkd
		Date	06/12/22
		Size	A4

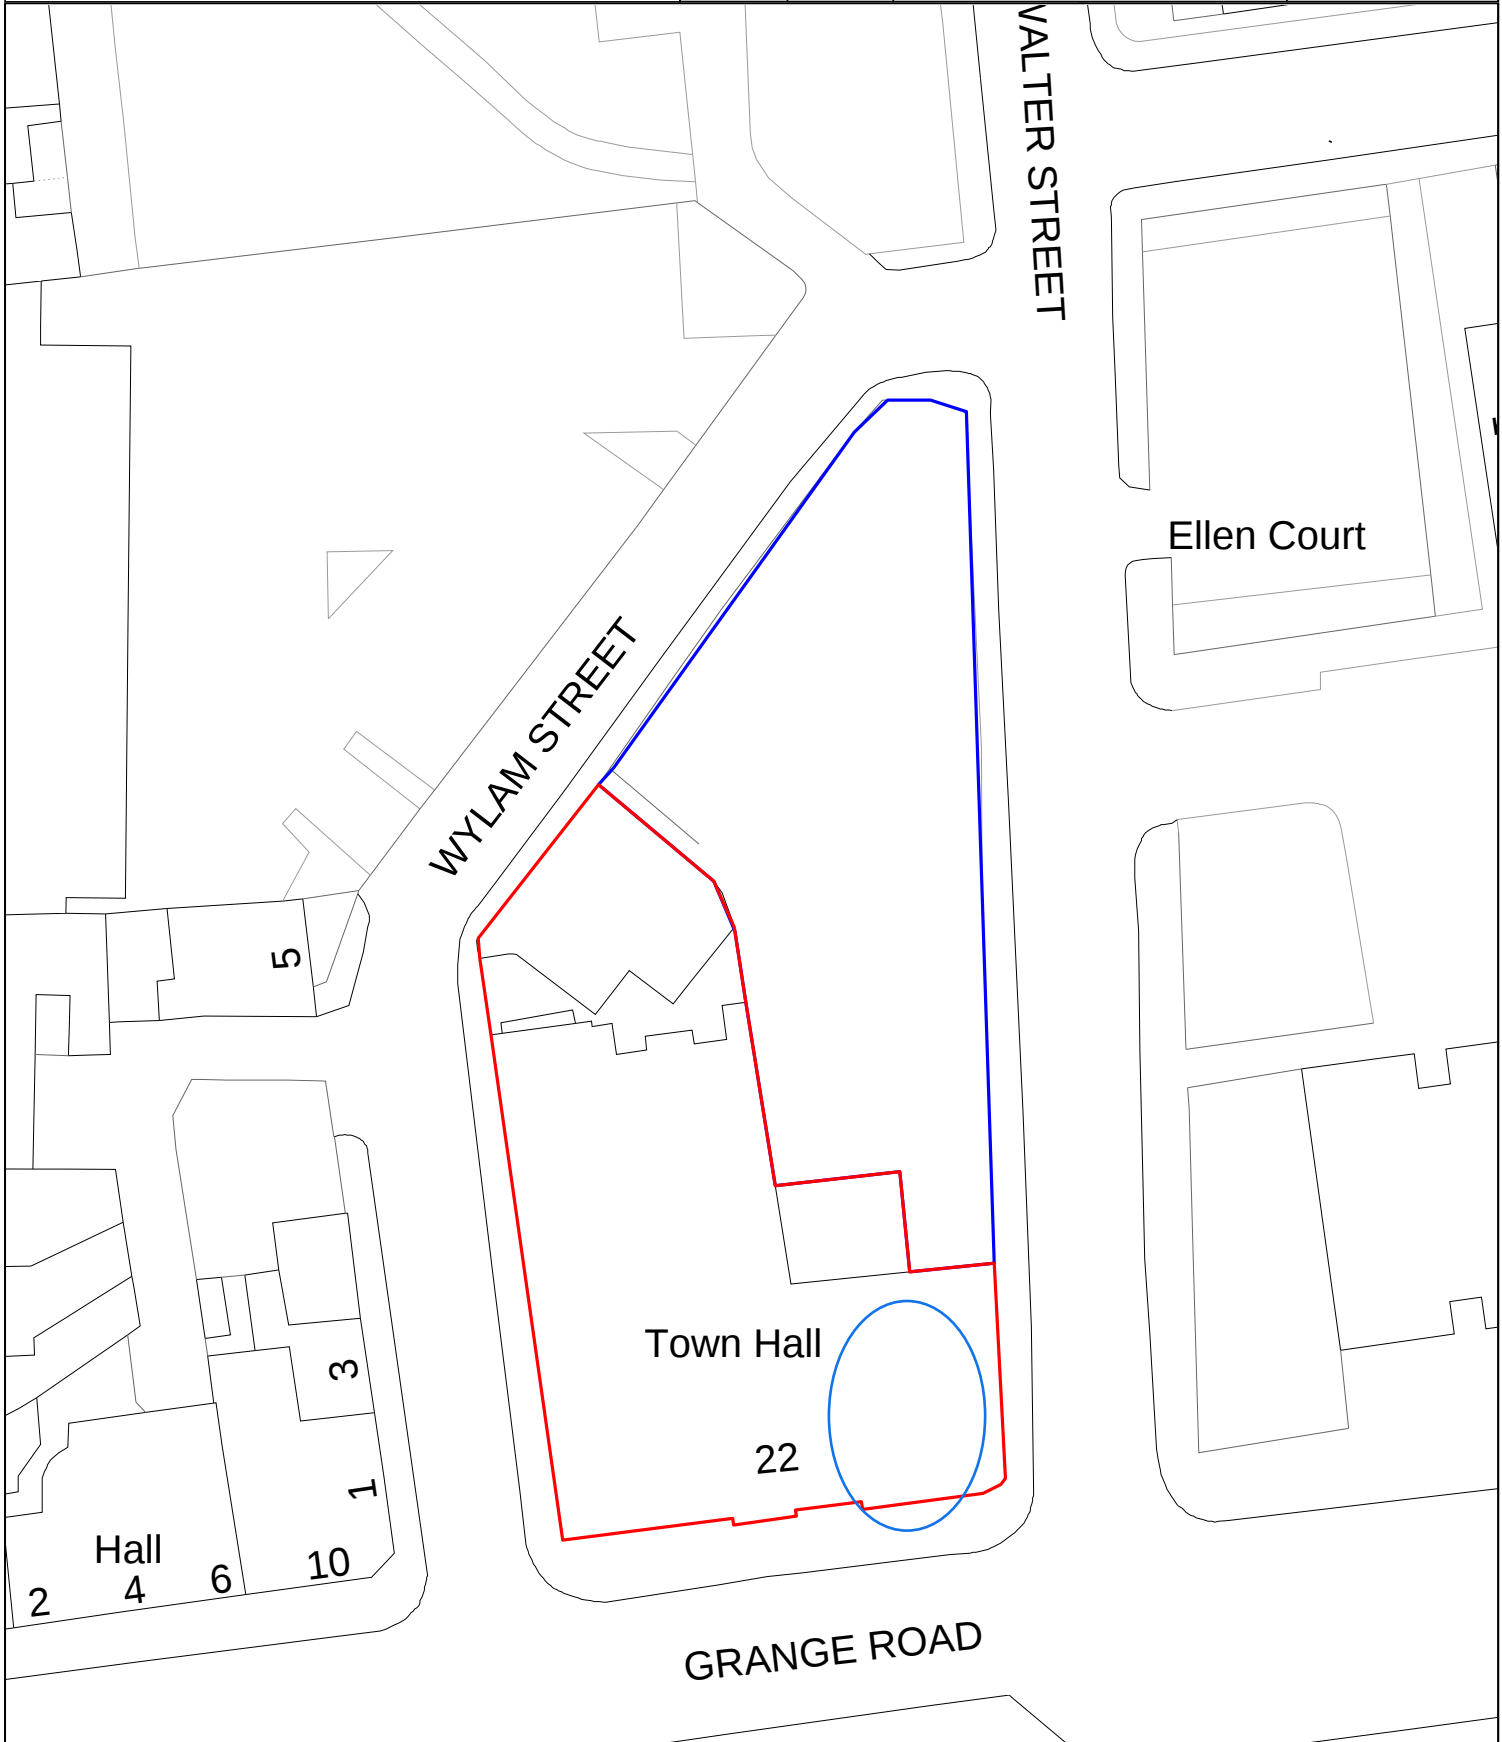

Ordnance Survey data has been reproduced from 1/1250 Ordnance Survey Maps with the permission of the Controller of H.M. Stationery Office. Crown Copyright reserved. Licence No. 100019570