Do Not Scale from Drawing. Any discrepencies to be reported to the Architect prior to fabrication or ordering.

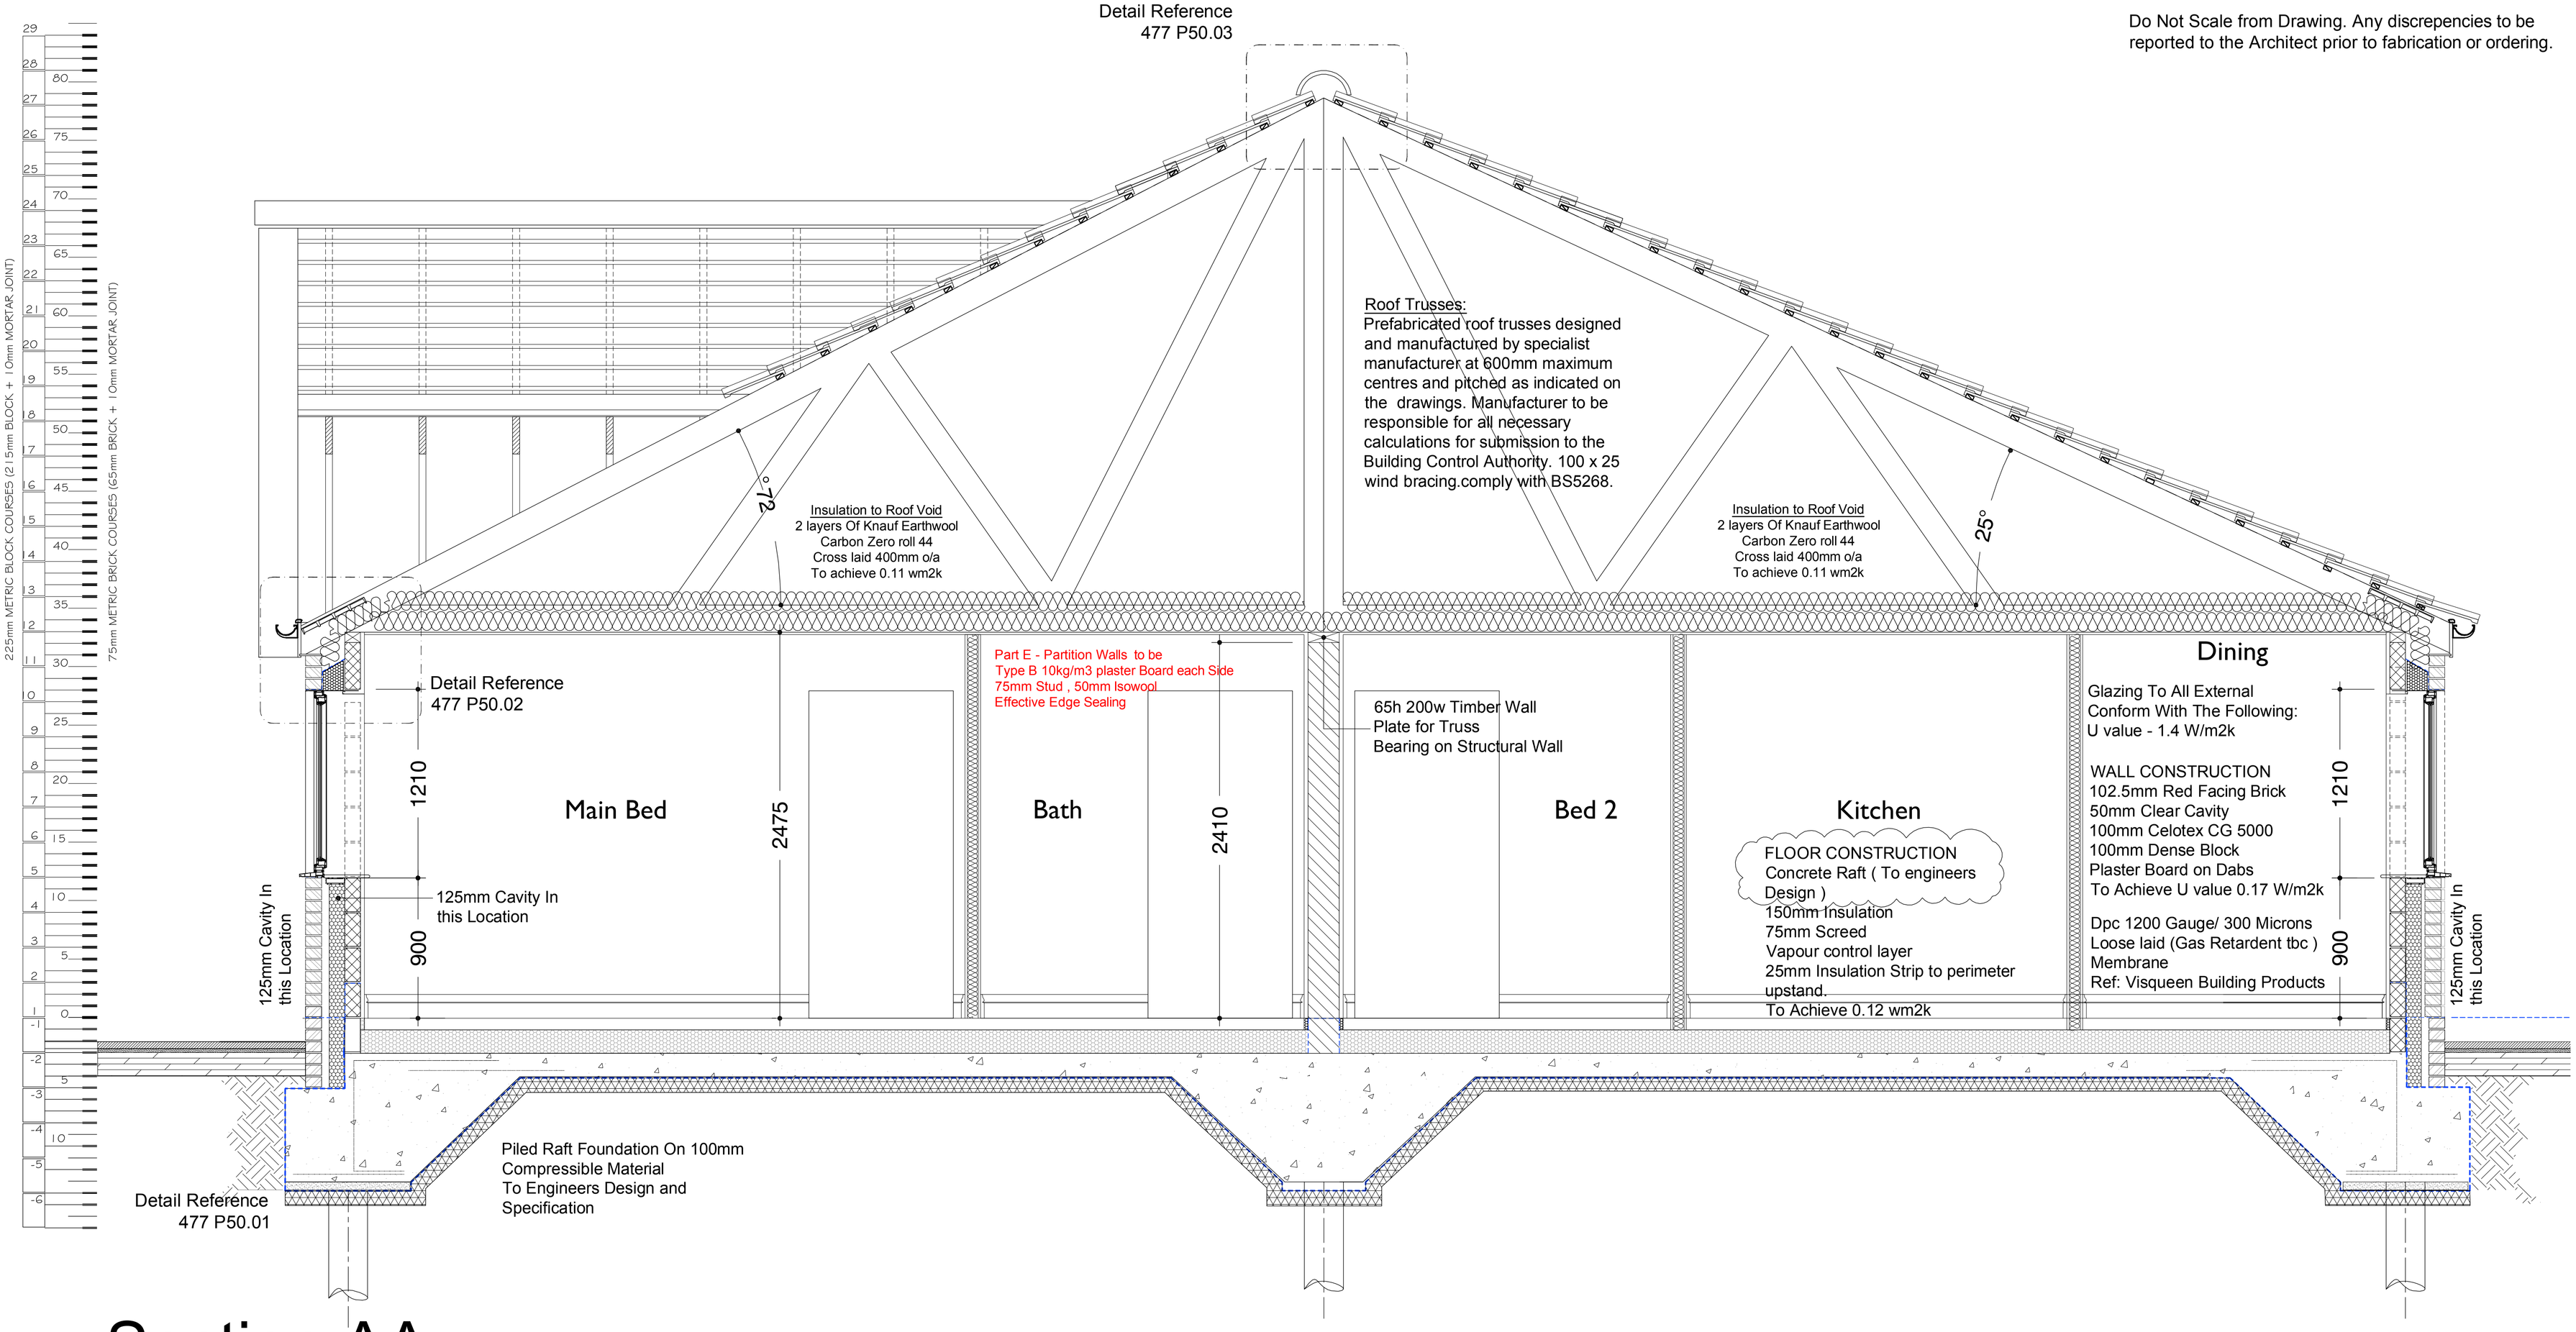

Section AA

REVISION	DATE	DESCRIPTION	CHECKED

CEAD
Community | Environment | Architecture | Delivery

JOB / CLIENT: South Tyneside Homes
Edhill Avenue

DWG TITLE: Proposed Bungalow Dwellings
Section AA

PROJECT NO.	DRAWING NO.	REVISION	STATUS
14.06	ED.SC.01	A	T

DRAWN	CHECKED	SCALE	DATE
PM	RM	1:50	MAY 15

Not to be reproduced without permission. Copyright CEAD Ltd.
STATUS: D=Draft R=Review P=Planning T=Tender C=Construction B=As-Built