


Existing Housetype Schedule

F2 variant	14 No.	616 sq.ft
F3	16 No.	619 sq.ft
Hutton	5No.	929 sq.ft
TOTAL	35 No.	27,973 sq.ft



Existing Layout

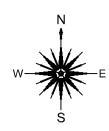

Proposed Housetype Schedule

rioposeu	Housetype	Juliedale
MACKLEY	3 No.	1220 sq.ft
MOSELEY	4 No.	739 sq.ft
HUTTON	4 No.	929 sq.ft
HANBURY	3 No.	761 sq.ft
RUNSWICK	2 No.	1171 sq.ft
GREYFRIARS	3No.	1068 sq.ft
TOTAL	19 No.	18.161 sa.ft



External Material Specification

(A_n) Hanson Worcestershire Red Multi

B[#] Turka Denton Cream

C_s Hanson Worcestershire Red Multi & Forticrete Anstone Buff

Note: Garage and binstore bricks to be as per the buildings they serve. Where clashes occur (eg. where a double garage serves a house of different brick types, Worcester Red to be used.

All roof tiles to be Marley Edgemere Smooth Grey

The subscript that follows the main brick indicates the front door colour. R = red, B = blue and G = green. All houses to have Cottage Style front doors (EGC102) and apartments to be six panel glass reinforced plastic.

Windows:


Other:

Foil wrapped upvc in 'Anthricite Grey'.


Render colour: white, smooth Cladding: Hardie Plank in Rustic Brown finish (refer to housetype working drawings.)


Mortar colour : standard grey Eaves fascia and soffit : white uPVC Rainwater goods : black


N.B. This material specification reflects the principles set out in the Phase 1 / 2 approval and ensures continuity is acheived into the application phase.

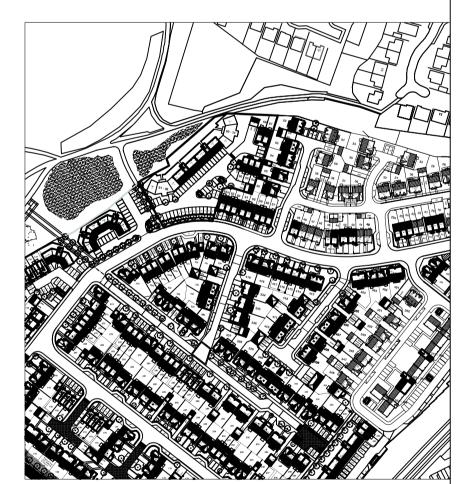


Location Plan 1:2500

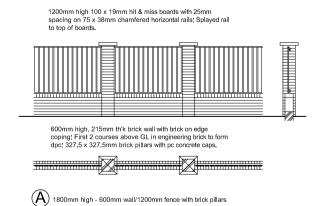

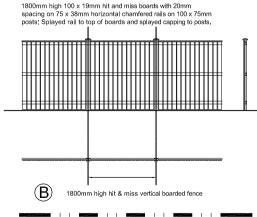

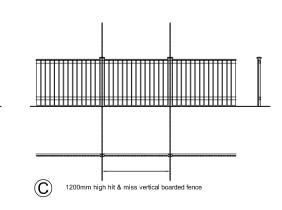

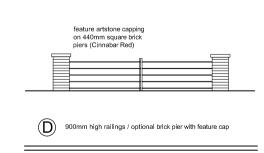

IMMON HOM	_

PERSIMMON HOMES NORTH EAST LTD P 2 ESH PLAZA SIR BOBBY ROBSON WAT GREAT PARK NEWCASTLE UPON TYNE NE13 9BA

Tel. 0191 2389950 Fax. 0191 2389993

DRG. No.	215/F	REMIX/002	REV D	REVISIONS	
SCALE	1:500	ORIGINAL DRAWING SHEET SIZE A2		A	
TITLE				В	
	1	/A Tech Hebburn		С	
					ſ

/A	Tech	Hel	oburn
I	Plots	64 -	98

Proposed Remix

DRAWN	CHECKED	DATE	
REVISIONS		DATE	
А	Additional gates added at request of LA Planners.	25.04.16	BY
В	VP added fronting plots 65 & 66 at request of LA Highways dept.	28.06.16	
С	External materials and boundary types added to layout.	18.07.16	
D	Red line boundary removed at request of Persimmon planning dept.	10.08.16	
	·		

WRITTEN DIMENSIONS TO BE TAKEN IN PREFERENCE TO SCALE. ALL DIMENSIONS TO BE CHECKED ON SITE AND ANY DISCREPANCIES REPORTED IMMEDIATELY.