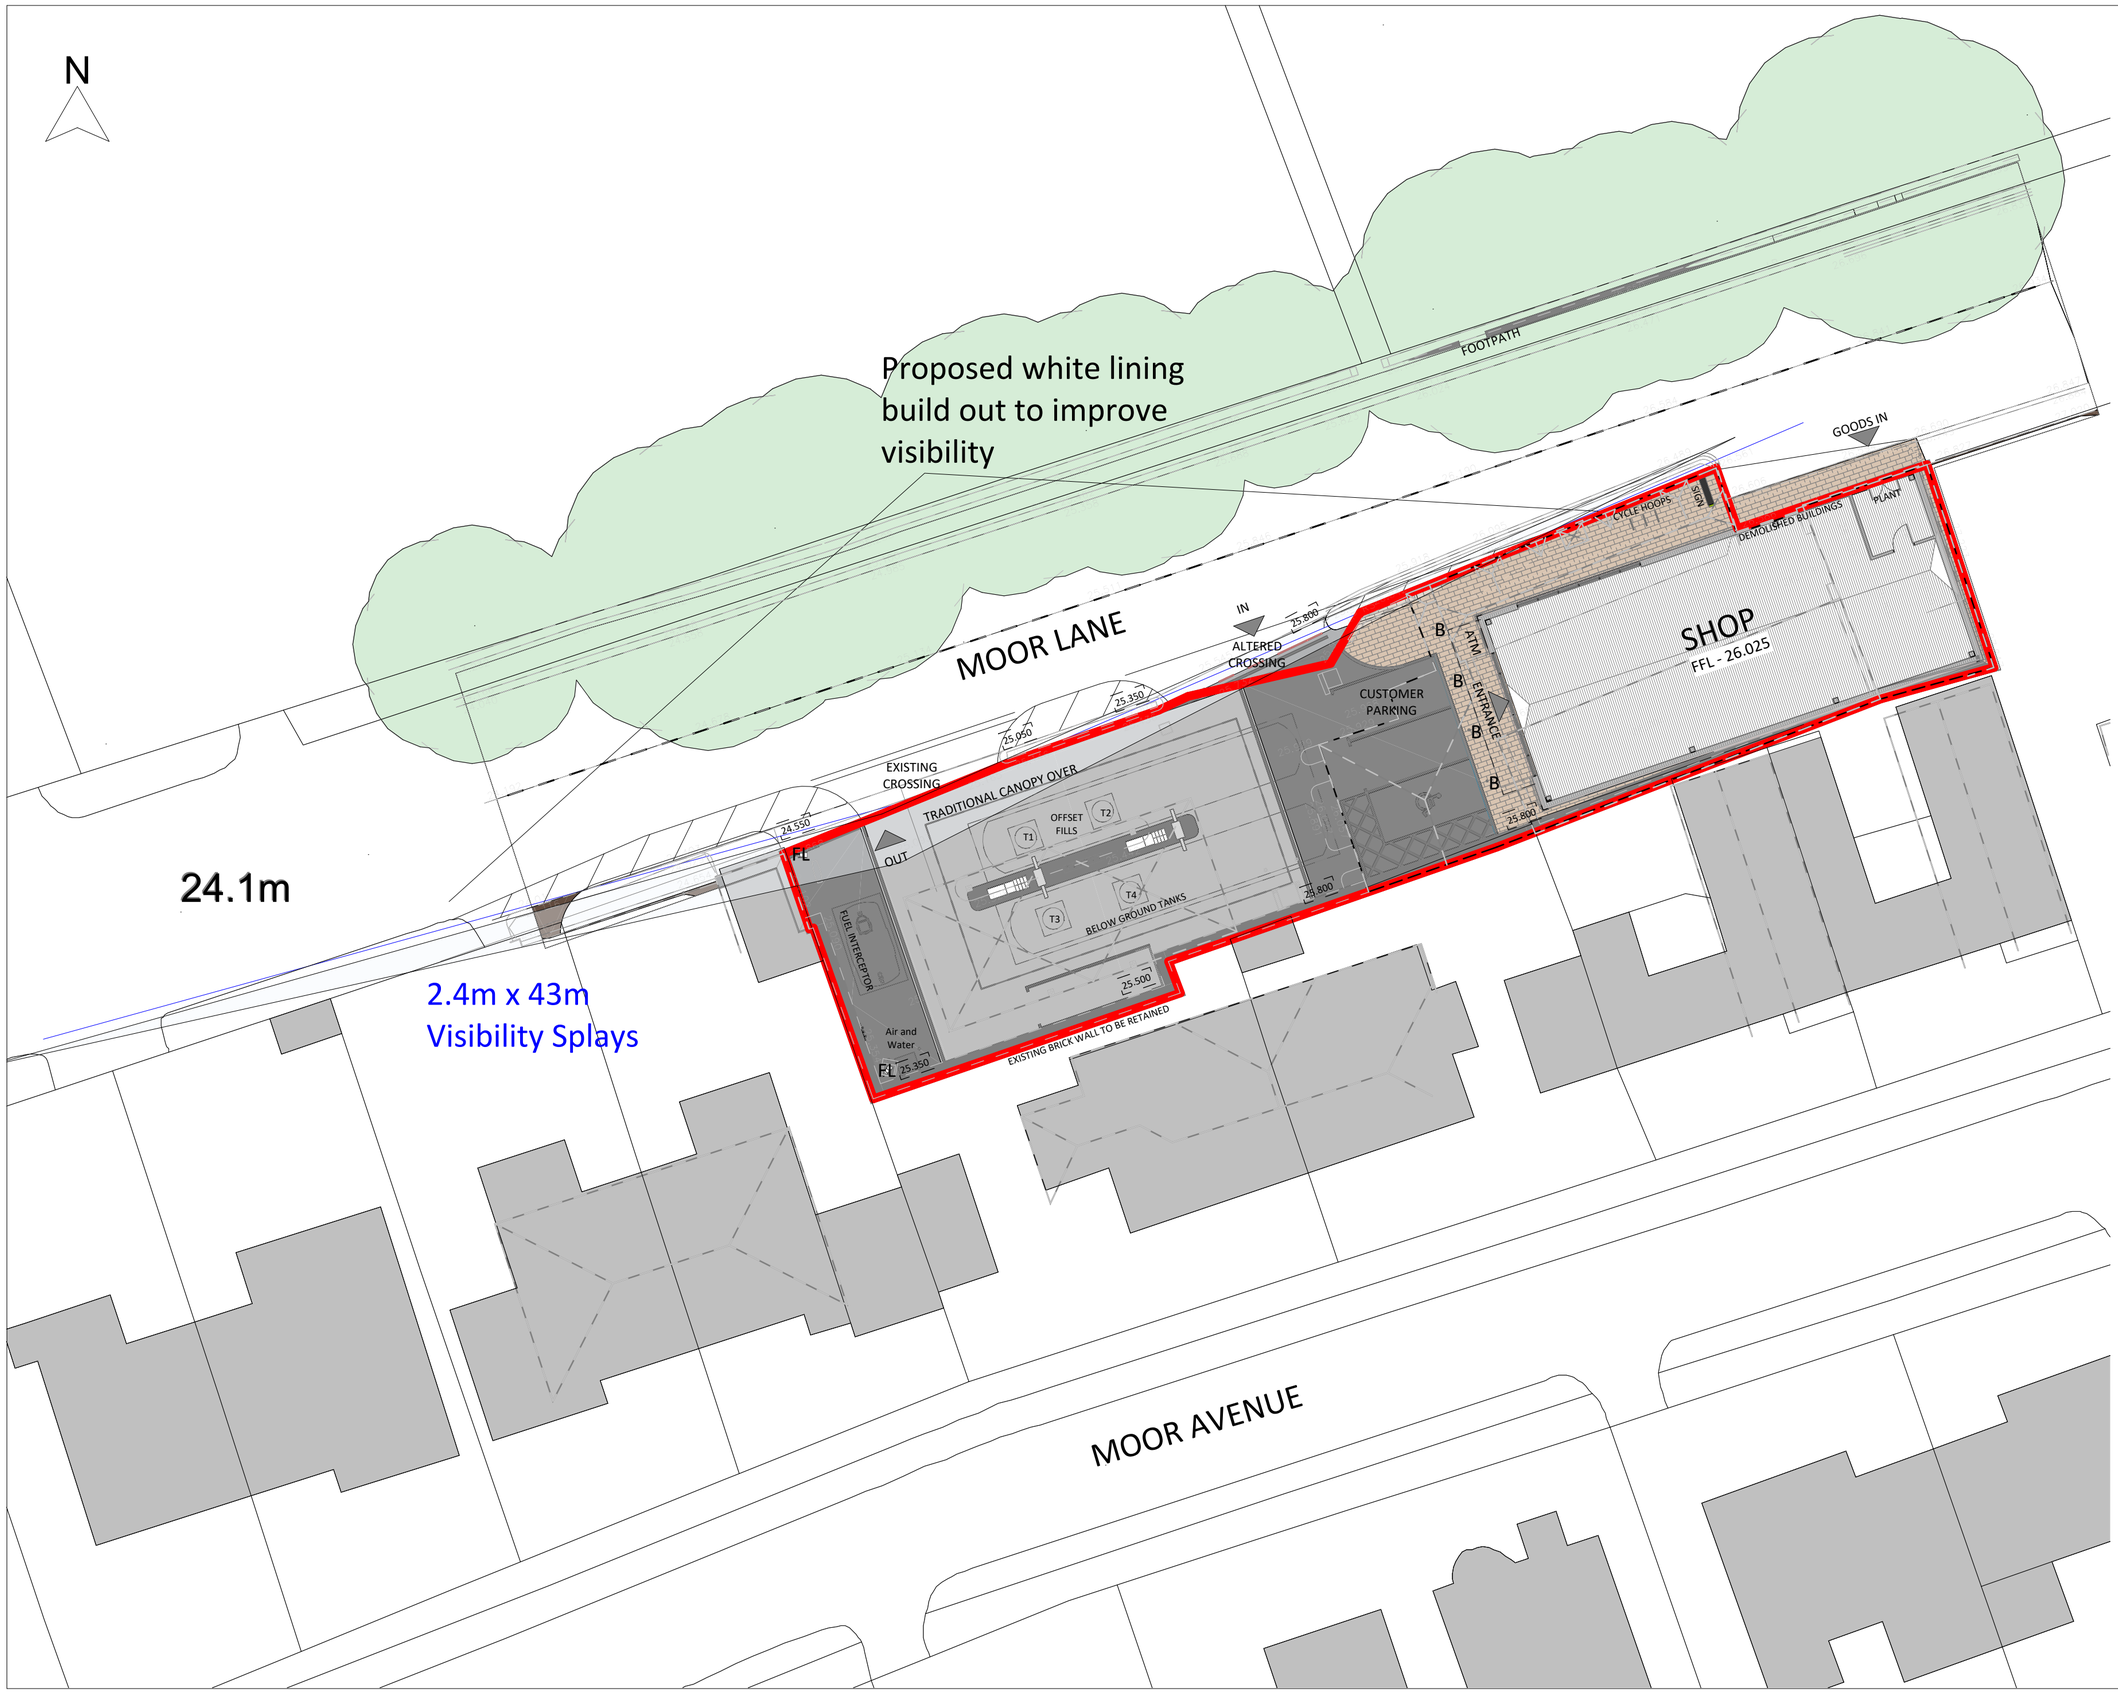


GENERAL NOTES

1. This plan has been prepared for the submission of planning approval only.
2. Any advertisement shown is subject to a seperate application.

DEMOLITION

EXISTING BUILDINGS TO BE DEMOLISHED, TANKS TO BE BROKEN OUT AND CANOPY TO BE DISMANTED. SITE TO BE CLEARED TO ENABLE REDEVELOPMENT.

HIGHWAYS

SITE ACCESS TO GENERALLY REMAIN AS EXISTING, PEDESTRIAN ACCESS AND ROAD ACCESS TO BE REVISED BY HIGHWAYS CONSULTANT.

BOUNDARY TREATMENTS

ALL BOUNDARY TREATMENTS ARE TO BE AS EXISTING, 3.5M HIGH BRICK WALL TO BE RETAINED AND MADE GOOD.

PROPOSED SHOP

SHOP TO BE NEW STEEL FRAMED CONSTRUCTION WITH MASONARY AND STONE FINISH. STORE TO HAVE ALUMINIUM GLAZING ON SIDE AND FRONT AND DOOR TO BE FITTED WITH SHUTTERS FOR NIGHT TIME CLOSURE.
BUILDING TO HAVE A FLAT ROOF WITH A MASONARY PARAPET, FINISHED WITH COPING STONES.
ALL MASONARY AND STONE WORK TO HARMONISE WITH LOCAL AREA.

FUEL INFRASTRUCTURE

2NO. 60,000 LITRE DOUBLE SKIN BELOW GROUND FUEL STORAGE VESSELS
2NO. 8 HOSE PUMPS
ALL PIPEWORK AND ASSOCIATED INFRASTRUCTURE IN ACCORDANCE WITH LATEST ISSUE OF THE THE BLUE BOOK

CANOPY

TRADITIONAL FORECOURT CANOPY SET WITH A MINIMUM 5M CANOPY HEIGHT TO ALLOW FOR ACCESS.
CANOPY TO BE FINISHED WITH WHITE ALUMINIUM PROFILED SOFFIT AND SMOOTH WHITE ALUMINIUM FASCIAS.
CANOPY TO BE FITTED WITH RECESSED LED SOFFIT LIGHTS AND TO ACHIEVE 100 LUX OVER THE TANKER STAND.

DRAINAGE

ALL EXISTING SURFACE AND FOUL WATER CONNECTIONS ARE TO BE REUSED AND ALL SURFACE WATER DISCHARGED FROM FORECOURT WILL BE CAPTURED WITH ACO (OR SIMILAR) DRAINAGED CHANNELS AND 10,000 LITRE CLASS 1 PETROL INTERCEPTOR.

LIGHTING

2NO. NEW FLOOD LIGHTS COMPRISING OF 4M IN HEIGHT WITH LED HEADS

SURFACE FINISHES:

Denotes macadam surfacing with a build up to be specified by an appointed engineer.

Denotes in-situ cast concrete paving.

Selected and approved blocked paving.

Property Schedule		
Application Boundary - Red Line	0.16 acres	0.06 hectare
Building Area		
Existing Gross Building Area	327.34 m²	3523.47 ft²
Proposed Gross Building Area	225.87 m²	2431.28 ft²
Parking Schedule		
Proposed Parking	Disabled Bay	1
Proposed Parking	Standard Parking Bay	2
Proposed 3 in 1 bay	3 in 1 Bay	1
Existing Parking		0

K	20.04.26	WHITE LINING OVERLAID	CS
J	19.11.25	PARKING SCHEDULE UPDATED	CS
I	13.11.25	RED LINE BOUNDARY UPDATED	CS
H	28.10.25	PARKING SPACED ADDED	CS
G	30.09.25	FUEL INTERCEPTOR ADDED	CS
F	01.07.25	EXIT AND ENTRANCE UPDATED AND VISIBILITY SPLAY ADDED	CS
E	29.05.25	UPDATED TO CLIENTS COMMENTS	CS
D	28.04.25	BOUNDARY UPDATED	CS
C	25.04.25	ROOF UPDATED TO CONSERVATION OFFICERS COMMENTS	CS
B	19.10.23	ATM ADDED AND GLAZING SIZE DECREASED	CS
A	31.08.23	PUMP CANOPY INCREASED AND PEDESTRIAN CANOPY REMOVED	CS

PLANNING

PROJECT
MOOR LANE GARAGE
MOOR LANE
SOUTH SHIELDS
NE34 6BZ

TITLE
PROPOSED LAYOUT

CLIENT
SRJ ENERGY

JENNINGS DESIGN
8 Feast Field, Horsforth, Leeds, West Yorkshire, LS18 4TJ
www.jennings-design.com 01274 395422 office@jennings-design.com

Drawn:	Check:	Scale:	Date:
CS	JHJ	1 : 200	JULY 2023

Plan Number:
230860- 04 (K)

0 2.5 m 5.0 m 10.0 m
SCALE: 1:200