
Revisions		
By	Details	Date

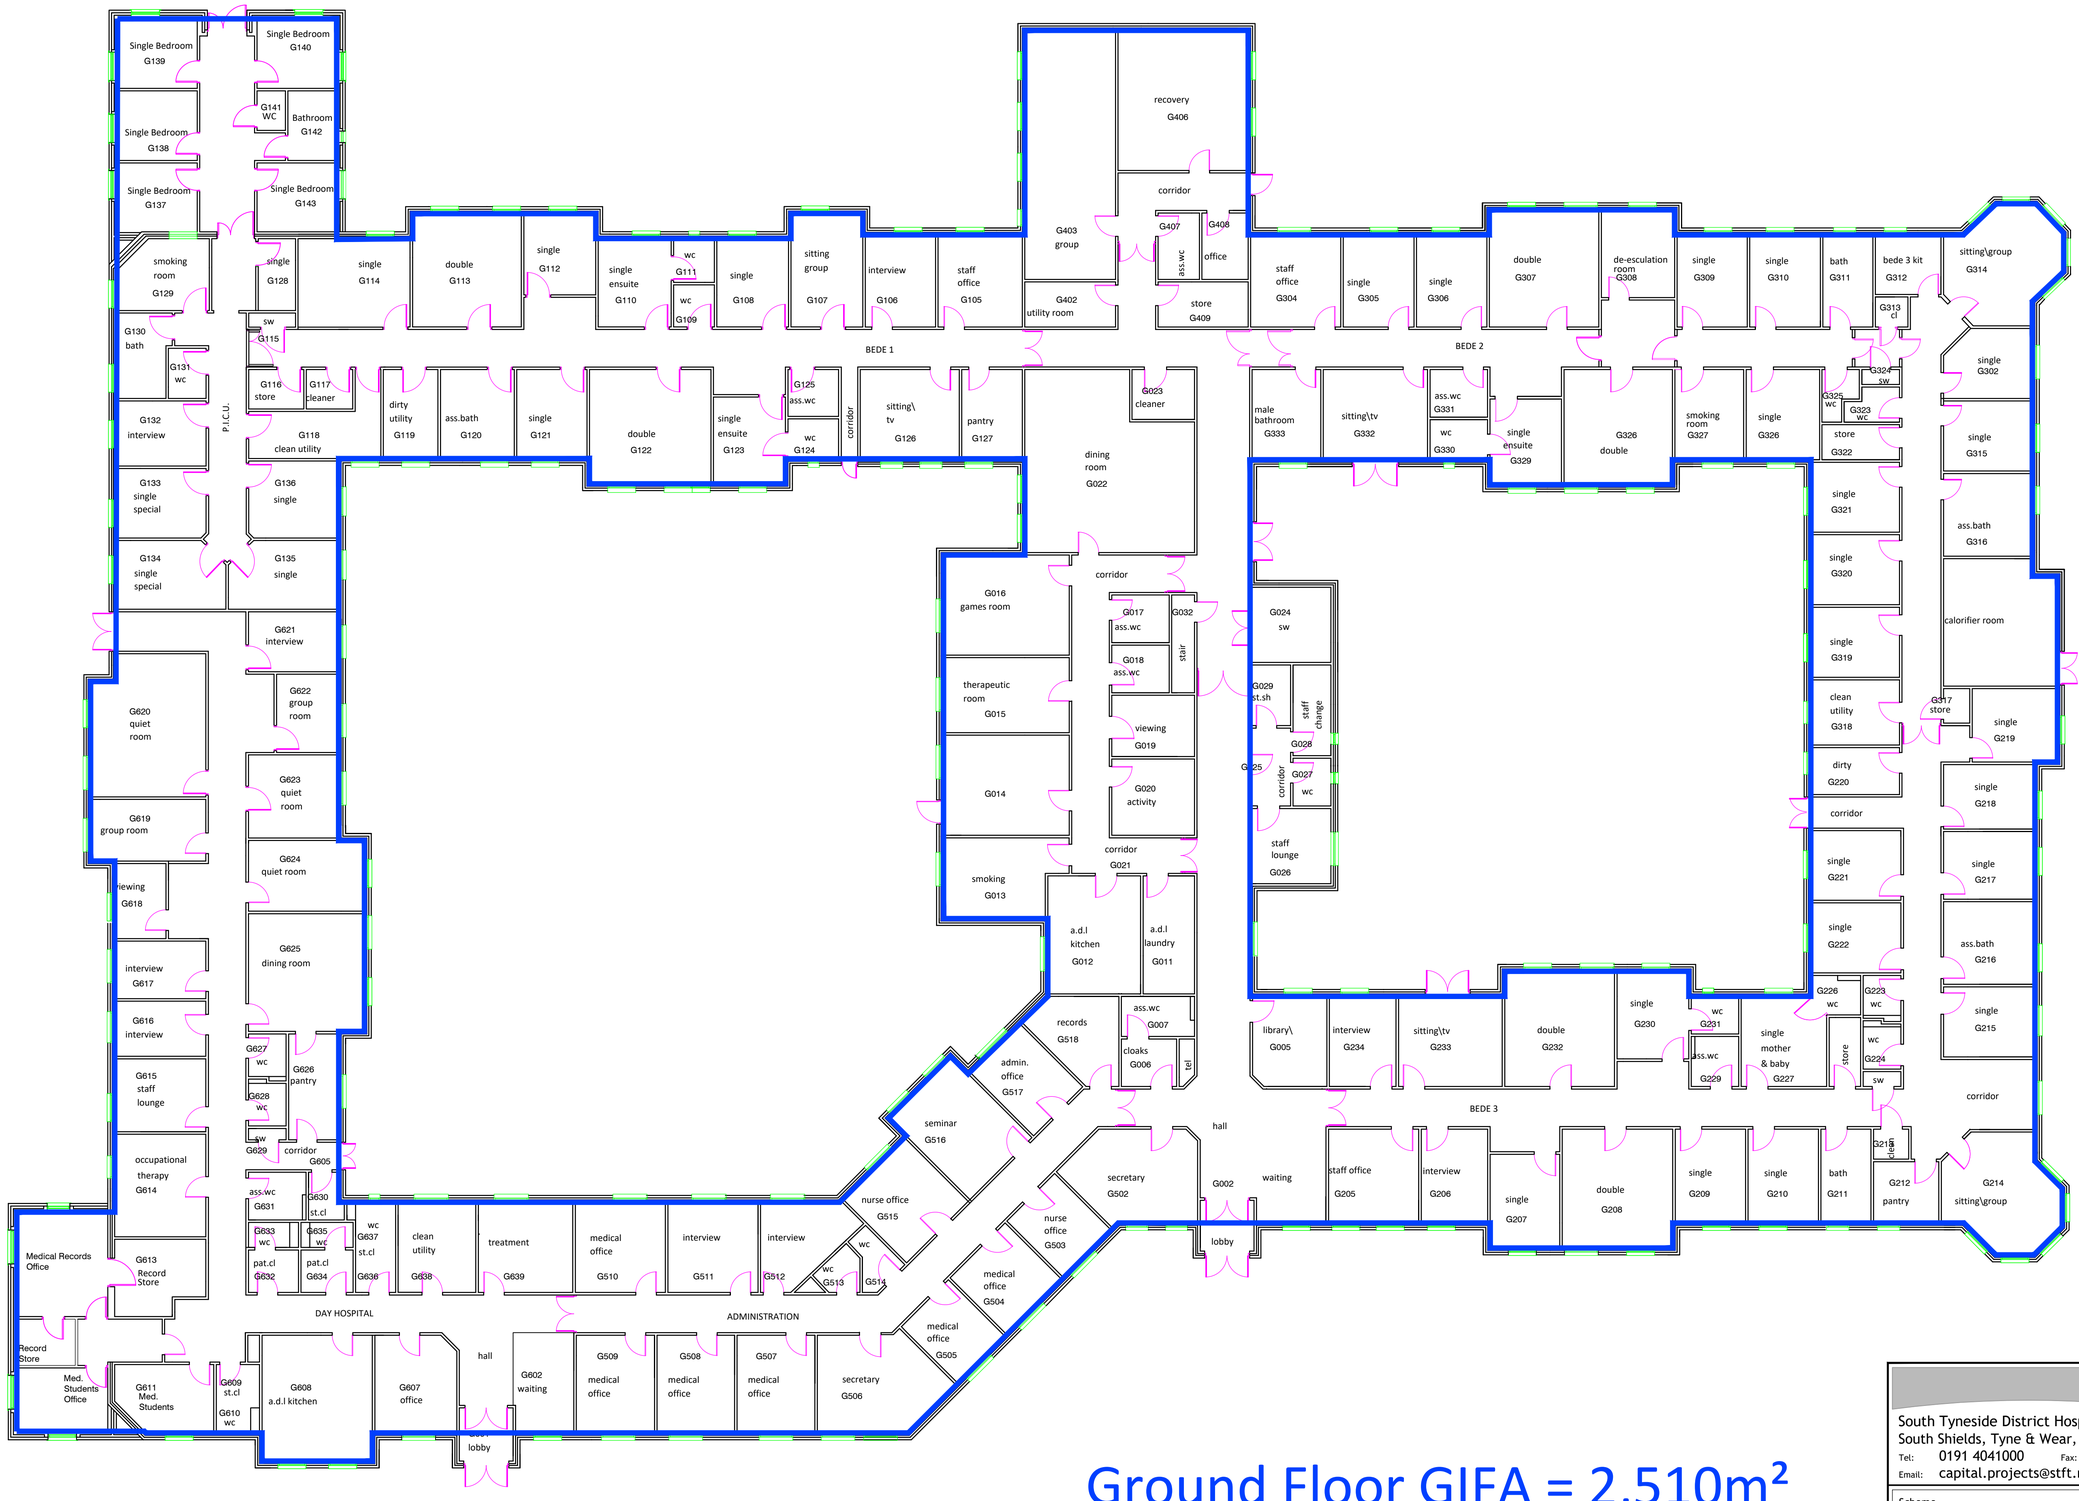

Ground Floor GIFA = 2,510m²

South Tyneside NHS
NHS Foundation Trust

South Tyneside District Hospital
South Shields, Tyne & Wear, NE34 0PL.
Tel: 0191 4041000 Fax: 0191 4277571
Email: capital.projects@stft.nhs.uk

Scheme
SOUTH TYNESIDE DISTRICT HOSPITAL
Estate Record Drawing

Title
BEDE WING
ground floor plan

Drawn AR | Date 1.7.14

Scale 1:125(A1)

Fixing Dimensions Must NOT be Scaled from this Drawing.

Drg. No.