Revisions		
Rev	Details	Date
A	Social Club (Block 5 Demolished 2010)	22.09.10
B	A&E Site compound / Entrance updated	22.09.10
C	Emergency Care and Ingham Wing Roadworks updated	14.02.12
D	Haven Court and Haven Court Car Park & Access added	14.08.16
E	Energy Centre added	08.05.20
F	Demolitions updated	19.04.23

KEY

3.East Block
Area Stores/Treasurers over
Postgraduate Medical Centre
/Social Services & Clinical
Psychology over.

6.Building Workshops.

7.Greenhouses & Seed Beds.

8.Engineering Workshops &
Boilerhouse & Stores

9.Ward 17

10.Pharmacy.

10a.Medical Gas Store.

11.Ward 19/Ward 18 over.Ward 20.

12.Geriatric Day Hospital (Moorlands).

13.Diagnostic Centre &
Haematology/Oncolgy A&E Dept..

14.Maternity Block.Wards 21-23.

17.Harton Wing.

18.The Nursery.

20.Acute Psychiatry 45 Bed Unit (Bede Wing).

21.Edythe Brown House.

24.Ingham Wing. Main Entrance
GF - EAU, Contact Centre,
Anaesthesia, O.T. & Physiotherapy
1st. - Surgical Centre, Wards 2&3
2nd. - Wards 5-8
3rd. - Wards 9-12

25.X-Ray Department.
I.T.U., Medical Records & H.S.D.U.
/Operating Theatres over.

26.Services Complex.

27.Cancer Services.

28.Mortuary

29.Medical Physics


30.Catering

31.Pathology/Estates

32.Energy Centre

Entrance / Exit

Bede Wing Demolition

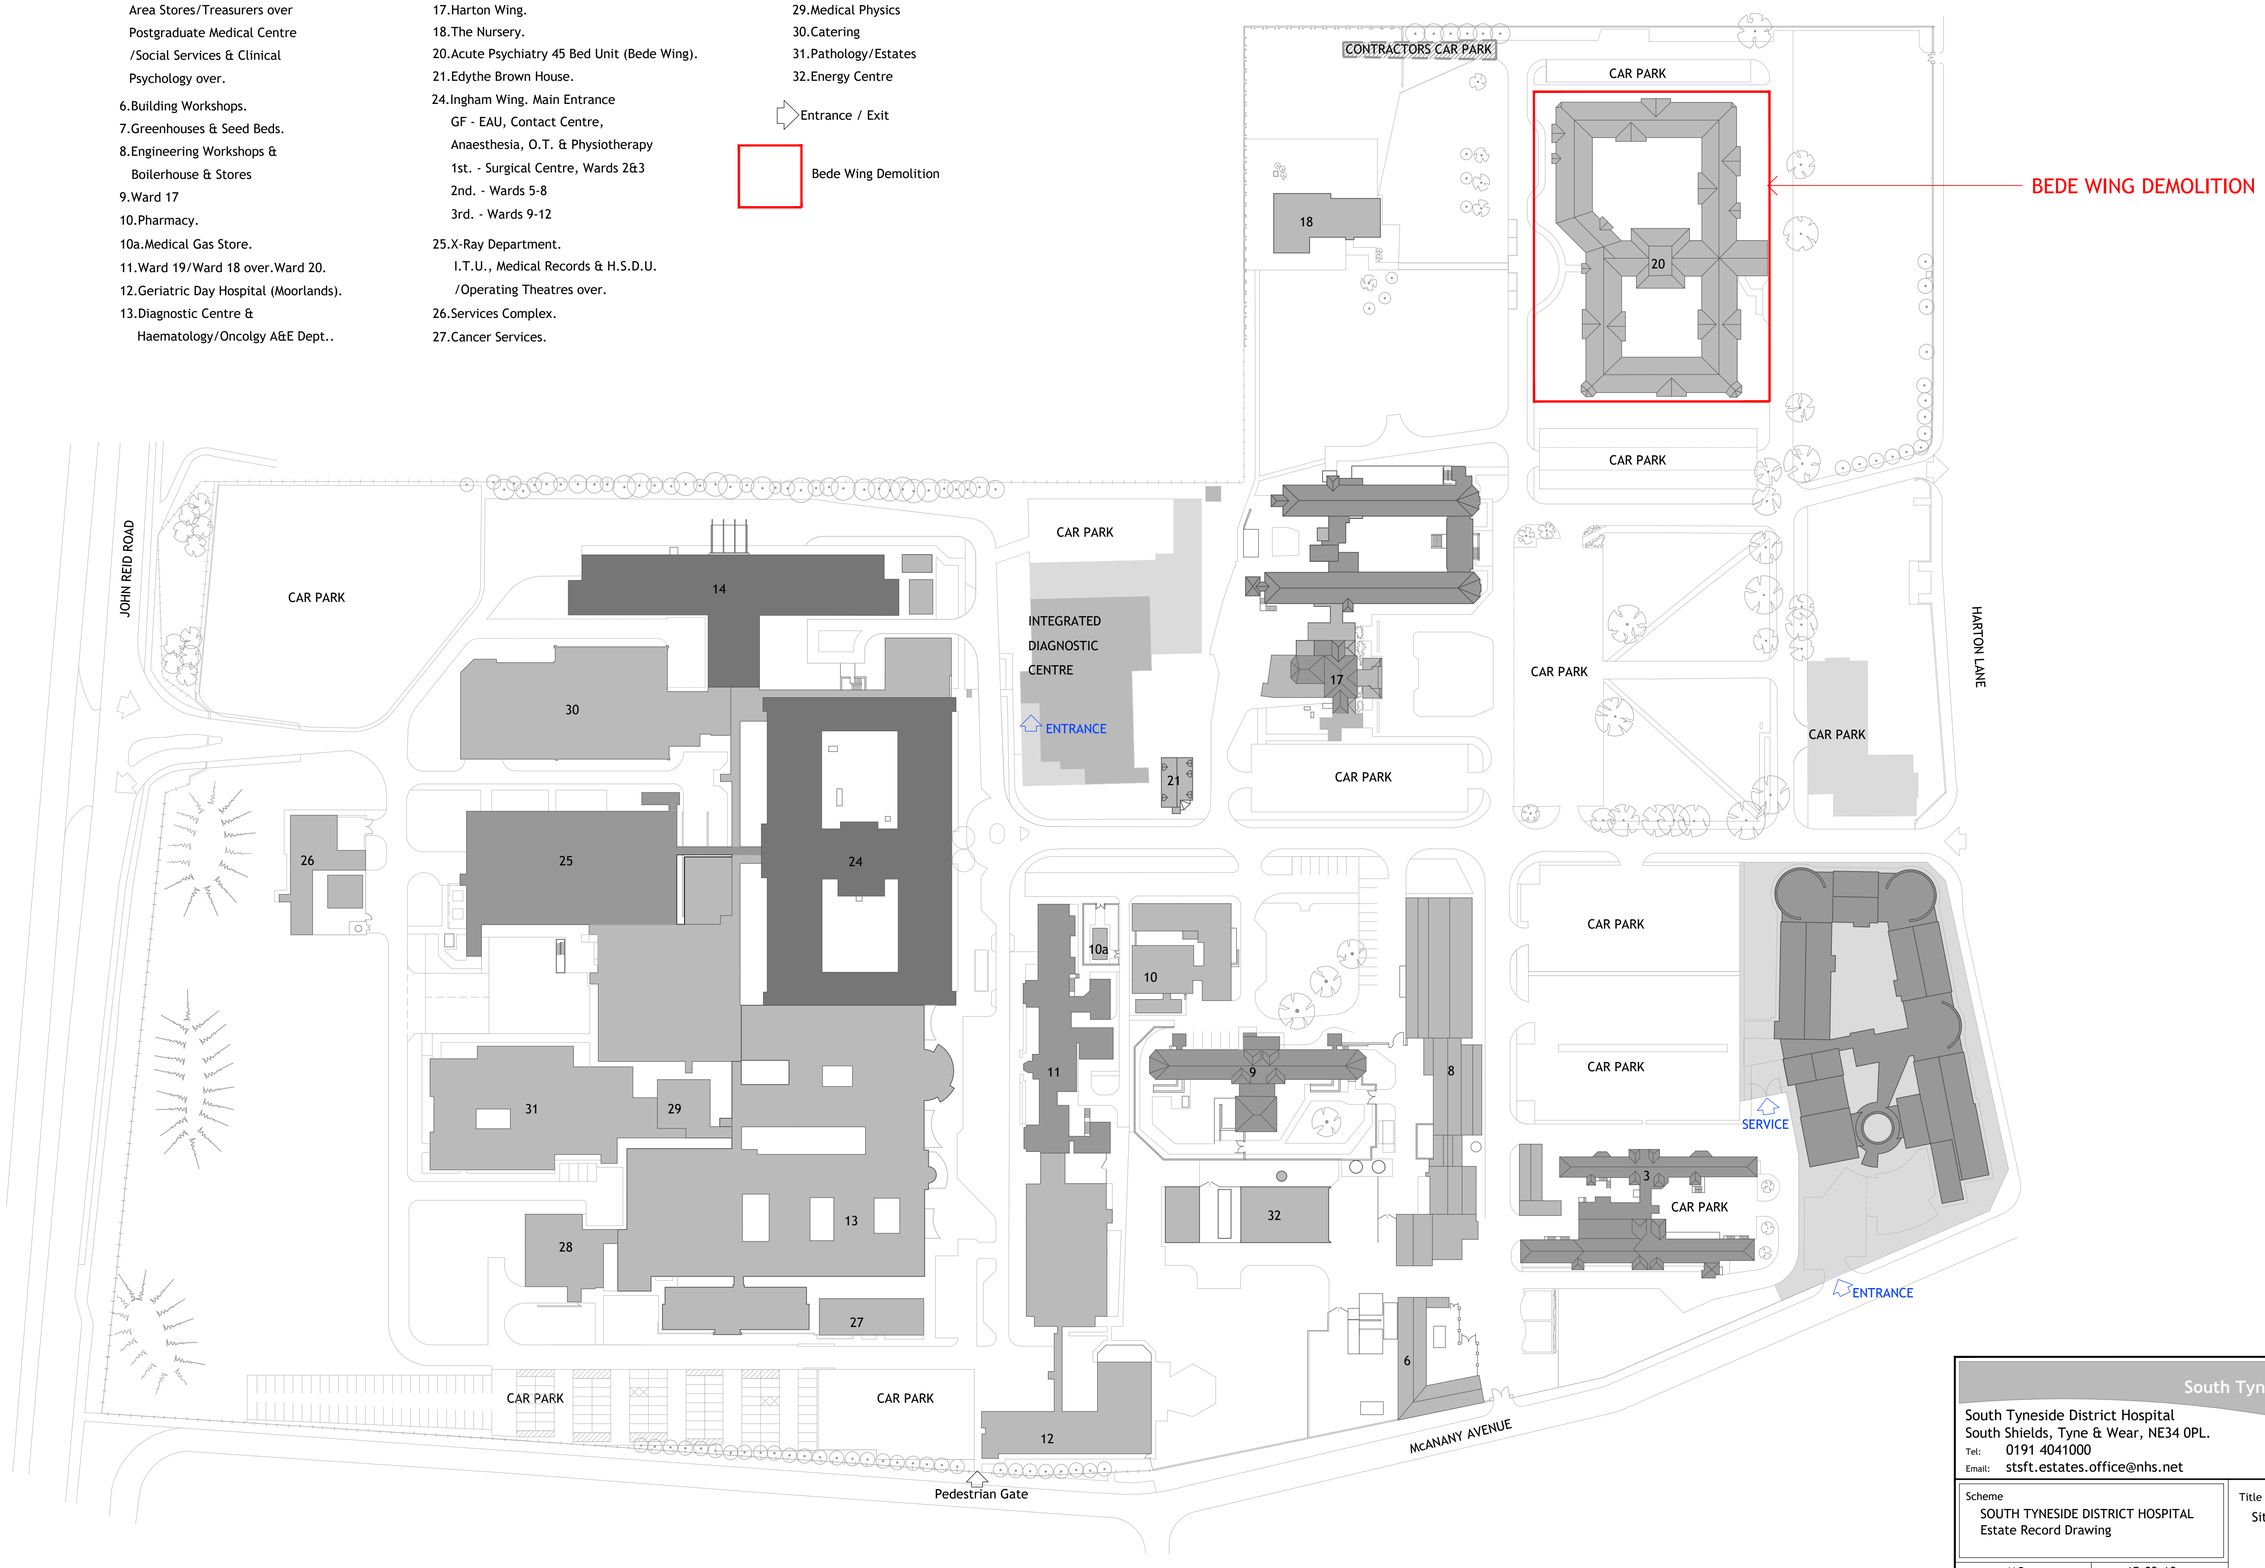

South Tyneside & Sunderland NHS
NHS Foundation Trust

South Tyneside District Hospital
South Shields, Tyne & Wear, NE34 0PL.
Tel: 0191 4041000
Email: stsft.estates.office@nhs.net

Scheme
SOUTH TYNESIDE DISTRICT HOSPITAL
Estate Record Drawing

Title
Site Plan

Drawn MC | Date 15.03.10

Scale NTS

Fixing Dimensions Must NOT be Scaled from this Drawing.

Drg. No. 01/ 00 /01_SITE